

CODED

6 137

WATER WELL DRILLERS LOG

Date: 9-1, 1965, Driller: Merritt Drilling Co County Winston

(Name)

(1) Owner of Land: Farrel Mills  
(Name)

Rt-1, Louisville, Miss.  
(Address)

(2) Location: 1 14 10  
1/4, 1/4, Sec. T R

10 miles West of Louisville  
(distance) (direction) (Nearest Town)

(3) Topography: Hilly  
(Hilly) (Flat) (Level)

(4) Purpose of Well: Domestic  
(Domestic Irrigation, Municipal, Industrial, Other)

Description & Color of Materials  
Sand, Clay, Red Clay, Shell, etc.

Thick-  
ness  
Feet

Depth  
Feet

Red clay

0 10

Red sand

18 21

Blue clay

21 27

White sand

27 80

Information upon completion of well:

(1) Diameter 2 inches.

(2) Total Depth 80 feet.

(3) Water Level 40 feet below top of ground.

(4) Cased to 70, Size 2

(5) Screen: Size 2 1/4, Length 6


(6) Were any formations sealed against pollution?

yes,  no.

If YES depth of formation \_\_\_\_\_

Why \_\_\_\_\_

Drillers Remarks:

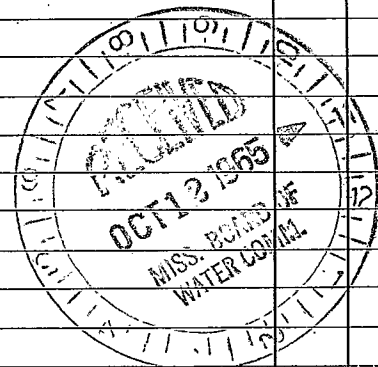

(Use Back Side)

Well No.

