

WINSTON  
H6  
12-29-70

MISSISSIPPI  
BOARD OF WATER COMMISSIONERS  
416 North State Street  
Jackson, Mississippi 39201

**CODED**

WATER WELL DRILLERS LOG

12-29 1970 Thomas & Son Winston  
date well completed firm name county well located

LANDOWNER: Ida M. Black  
14 west  
Louisville, Miss  
(mailing address)

description of formations encountered	from	to
<u>lime clay</u>	<u>0</u>	<u>18</u>
<u>black dirt</u>	<u>18</u>	<u>85</u>
<u>white sand</u>	<u>85</u>	<u>105</u>

WELL LOCATION:  
sec. 3 T 14 N R 10 E  
S  
9 1/2 miles W of Louisville  
(distance) (direction) (nearest town)

WELL PURPOSE:  
(home) irrigation, municipal, industrial

- WELL COMPLETION DATA:
- (1) diameter (inches) 2
  - (2) total depth (feet) 105
  - (3) static water level (feet) 40 below above top of ground.
  - (4) casing PVC 100  
(material) (depth)  
2 if telescope see back.  
(size)
  - (5) screen 5 100  
(length) (depth to top)  
1 1/4 3 slot 5-S.  
(size) (material)
  - (6) pump 1 9  
(HP) (yield gpm)  
Elec.  
(type power)
  - (7) electric log NO  
(yes or no)
- (organization running log)

**CODED**

(8) how well bottom plugged Point


DRILLERS REMARKS:

JAN 7 - 1971

MISS. Bd. OF  
WATER COMM.

If well telescopes please sketch and show depths.

GROUND LEVEL

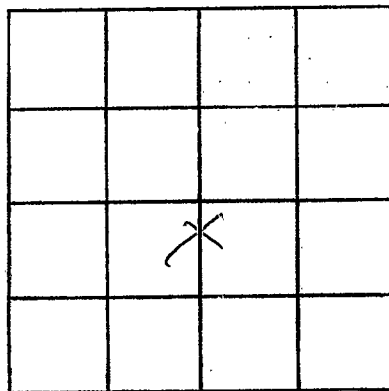

SECTION 3

Please indicate well location X.

ADDITIONAL INFORMATION

If more than one screen,  
show locations of each on sketch.