

**MISSISSIPPI
BOARD OF WATER COMMISSIONERS**
416 North State Street
Jackson, Mississippi 39201

CODED
CODED

WATER WELL DRILLERS LOG

Winstone
H 7
12-18-69

12-18 1969 J H McDaniel Winstone
date well completed firm name county well located

LANDOWNER:	description of formations encountered	from	to
<u>Charles Ramey</u>	<u>Red clay</u>	<u>0</u>	<u>20</u>
<u>Louisville Miss</u>	<u>pipe clay & sand</u>	<u>20</u>	<u>80</u>
(mailing address)	<u>& silt</u>		
WELL LOCATION:	<u>gray clay</u>	<u>80</u>	<u>100</u>
sec. <u>2</u> T <u>14</u> N R <u>10</u> E	<u>gray sand</u>	<u>100</u>	<u>135</u>
S W	<u>& silt</u>		
<u>1/2</u> miles <u>west</u> of <u>Louisville</u>			
(distance) (direction) (nearest town)			
WELL PURPOSE: <u>Home</u>			
(home, irrigation, municipal, industrial)			
WELL COMPLETION DATA:			
(1) diameter (inches) <u>2"</u>			
(2) total depth (feet) <u>135</u>			
(3) static water level (feet) <u>60</u> <small>below above</small>			
top of ground.			
(4) casing <u>2" galv.</u> <u>92</u>			
(material) (depth)			
(size) if telescope see back.			
(5) screen <u>2mm</u> <u>6</u>			
(length) (depth to top)			
(size) (material)			
(6) pump <u>1 set</u> <u>6</u>			
(HP) (yield gpm)			
<u>Galv.</u>			
(type power)			
(7) electric log <u>no</u>			
(yes or no)			
(organization running log)			
(8) how well bottom plugged			

JAN 21 1970


MISS. DEPT. OF
WATER CONTROL

DRILLERS REMARKS:

Open well
it was called as
well Digger a - - in Lake.

If well telescopes please sketch and show depths.

GROUND LEVEL

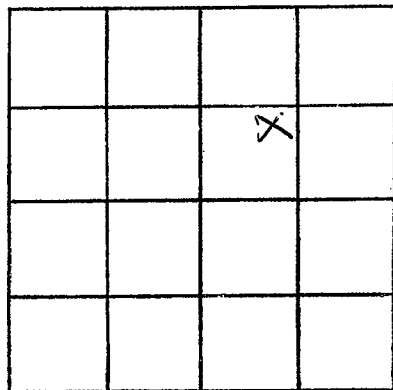

SECTION 2

Please indicate well location X.

ADDITIONAL INFORMATION

If more than one screen,
show locations of each on sketch.