

Winston  
H 8  
12-24-69

MISSISSIPPI  
BOARD OF WATER COMMISSIONERS  
416 North State Street  
Jackson, Mississippi 39201

CODED  
CODED

WATER WELL DRILLERS LOG

12-24-69 date well completed 1969 J. H. McDonald firm name Winston county well located


LANDOWNER:	description of formations encountered	from	to
T. J. Mills Louisville Miss	Red clay & sand		65
(mailing address)	Grey clay	65	120
WELL LOCATION:	fine sand & salt	120	160
sec. 1 T. 14 N. R. 10 E. S. 1 W.			
7.4 miles West of Louisville			
(distance) (direction) (nearest town)			
WELL PURPOSE: Home			
(home, irrigation, municipal, industrial)			
WELL COMPLETION DATA:			
(1) diameter (inches) 2"			
(2) total depth (feet) 160			
(3) static water level (feet) 100 below top of ground. 126 above			
(4) casing 2" dia. 126 (material) (depth)			
(size) if telescope see back.			
(5) screen none (length) (depth to top)			
(size) (material)			
(6) pump 1 HP 4 (yield gpm)			
EL. (type power)			
(7) electric log no. (yes or no)			
(organization running log)			
(8) how well bottom plugged			
DRILLERS REMARKS:			
open well no screen			

JAN 2-1 1970

Mississippi State Board of Water Commissioners

If well telescopes please sketch and show depths.

GROUND LEVEL

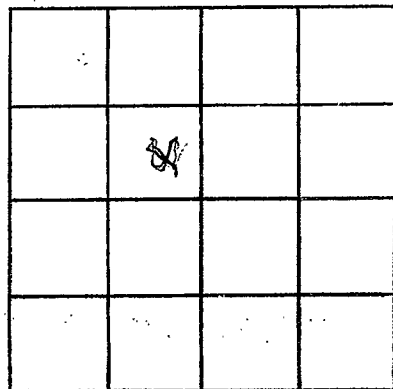

SECTION 1

Please indicate well location X.

ADDITIONAL INFORMATION

If more than one screen, show locations of each on sketch.