

WINSTON
H 9
3-3-71

MISSISSIPPI
BOARD OF WATER COMMISSIONERS
416 North State Street
Jackson, Mississippi 39201

CODED

WATER WELL DRILLERS LOG

3-3 1971 Thomas & Son Winston
date well completed firm name county well located

LANDOWNER: Fred Taylor
Louisville, Miss.
(mailing address)

WELL LOCATION:
sec. 31 T 14 N R 10 E
S W
15 miles NW of NOXAPATER
(distance) (direction) (nearest town)

WELL PURPOSE:
(Home, Irrigation, municipal, industrial)

- WELL COMPLETION DATA:
- (1) diameter (inches) 2
 - (2) total depth (feet) 210
 - (3) static water level (feet) 75 ^(below) _(above) top of ground.
 - (4) casing Galv. 168
(material) (depth)
2 If telescope see back.
(size)
 - (5) screen open
(length) (depth to top)
(size) (material)
 - (6) pump 2 AirComp 15
(HP) (yield gpm)
elec
(type power)
 - (7) electric log No
(yes or no)
(organization running log)
 - (8) how well bottom plugged open

description of formations encountered	from	to
Red Clay	0	8
Chalk	8	22
Black Dirt	22	66
Red Chalk & Fine Sand	66	75
Black Dirt	75	81
Chalky Sand	81	90
Black Dirt	90	105
Fine Sand	105	115
Hard Black Dirt	115	140
Blue Dirt	140	170
Green Sand	170	205
Hard Dirt	205	210

CODED


MAR 23 1971

MISS. BD. OF
WATER COMMISSIONERS

DRILLERS REMARKS:

If well telescopes please sketch and show depths.

GROUND LEVEL

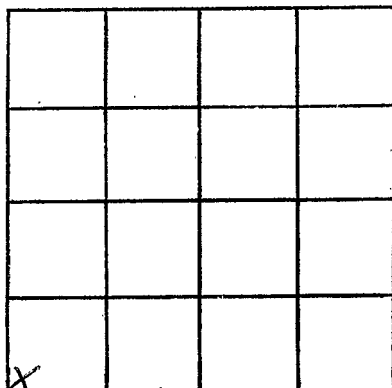

SECTION 31

Please indicate well location X.

ADDITIONAL INFORMATION

If more than one screen, show locations of each on sketch.