

WINSTON
H 10
3-5-73

MISSISSIPPI
BOARD OF WATER COMMISSIONERS
416 North State Street
Jackson, Mississippi 39201

WATER WELL DRILLERS

CODED

3-5 1973
date well completed

firm name

Winston
county well located

LANDOWNER:	description of formations encountered	from	to
Woodroe Taylor Lewisville, Miss.	Red CLAY	0	3
	fine CLAY	3	22
	STRs CHALK & SAND	22	30
(mailing address)	Grey CHALK	30	79
WELL LOCATION:	Rock 4 inches	79	
sec. 31 T. 14 N. R. 10 E	Grey CHALK	79	96
14 miles S.E. of Lewisville	Fine silt sand & chalk	96	96
(distance) (direction) (nearest town)	BLACK DIRT	96	123
WELL PURPOSE:	Lignite	123	124
(Home, Irrigation, municipal, industrial)	Grey silty SAND	124	126
WELL COMPLETION DATA:	Grey CHALK	126	166
(1) diameter (inches) 2	STRs Green SAND	166	176
(2) total depth (feet) 210	CHALK		
(3) static water level (feet) 70 (below top of ground)	Mostly All Fine	176	210
(4) casing (material) PVC (depth) 160	Green SAND		
(size) 2 (if telescope see back)			
(5) screen (length) open (depth to top)			
(size) (material)			
(6) pump (HP) 1 (yield gpm) 6			
(type power) Elec			
(7) electric log (yes or no) NO			
(organization running log)			
(8) how well bottom plugged open			
DRILLERS REMARKS:			


CODED

MAY 18 1973

FIG. 20, OF
WATER COMM.

If well telescopes please sketch and show depths.

GROUND LEVEL

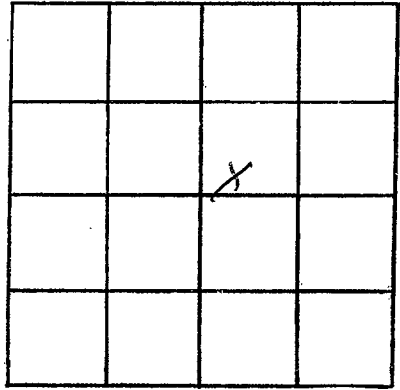

SECTION 31

Please indicate well location X.

ADDITIONAL INFORMATION

If more than one screen,
show locations of each on sketch.