

WINSTON
H II
7-19-73

MISSISSIPPI
BOARD OF WATER COMMISSIONERS
416 North State Street
Jackson, Mississippi 39201

CODED

WATER WELL DRILLERS LOG

7-19 1973 JHM^o Donald Winston
date well completed firm name county well located

LANDOWNER: Gary Burchfield
Louisville Miss
(mailing address)

description of formations encountered	from	to
red clay	0	30
gray clay	30	110
fine gray sand	110	140

WELL LOCATION:
sec. 31 T 14 N R 10 E
17 miles SW of Louisville
(distance) (direction) (nearest town)

WELL PURPOSE:
(home, irrigation, municipal, industrial)

- WELL COMPLETION DATA:
- (1) diameter (inches) 21
 - (2) total depth (feet) 140
 - (3) static water level (feet) 55 below above top of ground.
 - (4) casing steel 105 (material) (depth)
2 (size) if telescope see back.
 - (5) screen (length) (depth to top)
(size) (material)
 - (6) pump 3 5 (HP) (yield gpm)
electrical (type power)
 - (7) electric log no (yes or no)
(organization running log)
 - (8) how well bottom plugged open


CODED

SEP 5 1973

DRILLERS REMARKS:

If well telescopes please sketch and show depths.

GROUND LEVEL

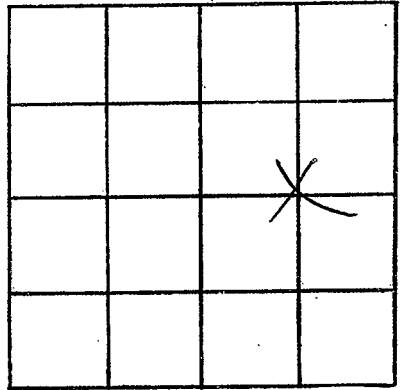

SECTION 31

Please indicate well location X.

ADDITIONAL INFORMATION

If more than one screen,
show locations of each on sketch.