

WINSTON
H 12
3-14-74

MISSISSIPPI
BOARD OF WATER COMMISSIONERS
416 North State Street
Jackson, Mississippi 39201

WATER WELL DRILLERS LOG

3-14
date well completed

1974 J. H. M. Daniels
firm name

Winston
county well located

LANDOWNER: <u>Ronald Lawson</u>	description of formations encountered	from	to
<u>Louisville Miss</u> (mailing address)			
	<u>red clay</u>	<u>0</u>	<u>15</u>
	<u>gray silty clay</u>	<u>15</u>	<u>105</u>
	<u>gray clay</u>	<u>105</u>	<u>114</u>
	<u>gray sand</u>	<u>114</u>	<u>126</u>

WELL LOCATION:

sec. 31 T. 14N R. 10E
15 miles S.W. of Louisville
 (distance) (direction) (nearest town)

WELL PURPOSE: Home
 (home, irrigation, municipal, industrial)

WELL COMPLETION DATA:

- (1) diameter (inches) 2
- (2) total depth (feet) 126
- (3) static water level (feet) 60 below above top of ground.
- (4) casing steel, 105
 (material) (depth)
2"
 (size) if telescope see back.
- (5) screen 5', 126 121
 (length) (depth to top)
1/4", 60 55
 (size) (material)
- (6) pump 1 7
 (HP) (yield gpm)
electric
 (type power)
- (7) electric log no
 (yes or no)

(organization running log)


(8) how well bottom plugged

DRILLERS REMARKS:

DRILLER'S SIGNATURE
 APR - 2 1974

If well telescopes please sketch and show depths.

GROUND LEVEL

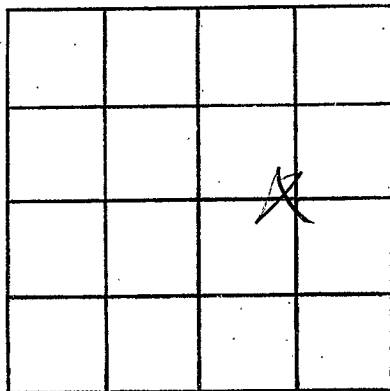

SECTION 31

Please indicate well location X.

ADDITIONAL INFORMATION

If more than one screen, show locations of each on sketch.