

WE DON'T HAVE A WINSTON COUNTY MAP.

*Corrected 4/24/68*

CODED

3 13T

*SR*

Winston
J 8
3-67

MISSISSIPPI  
 BOARD OF WATER COMMISSIONERS  
 416 North State Street  
 Jackson, Mississippi 39201  
**WATER WELL DRILLERS LOG**

APRIL 17 1967 OGLETTREE DRILLING WINSTON  
 date well completed firm name county well located

LANDOWNER: FELIX WATKINS

description of formations encountered

from to

NOXAPATER

RED CLAY

0 30

BLUE CHALK

30 45

(mailing address)

GRAY SAND

45 60

WELL LOCATION:


sec. 36 T. 14 N. R. 11 E  
 S W  
 5 miles N.W. of NOXAPATER  
 (distance) (direction) (nearest town)

WELL PURPOSE: HOME USE  
 (home, irrigation, municipal, industrial)

WELL COMPLETION DATA:


- (1) diameter (inches) 2"
- (2) total depth (feet) 60
- (3) static water level (feet) 30 below above  
 top of ground.
- (4) casing GA. 55  
 (material) (depth)  
  if telescope see back.  
 (size)
- (5) screen 5' 55  
 (length) (depth to top)  
1 1/4 STAINLESS STEEL  
 (size) (material)
- (6) pump 1 6  
 (HP) (yield gpm)  
 REA  
 (type power)
- (7) electric log    
 (yes or no)  
   
 (organization running log)
- (8) how well bottom plugged  
FLUSH VALUE

DRILLERS REMARKS:

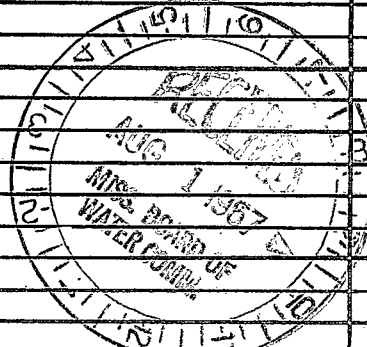

If well telescopes please sketch and show depths.

GROUND LEVEL

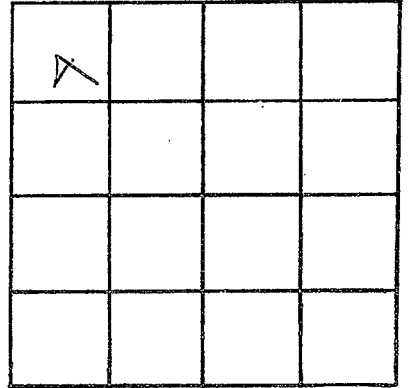

SECTION \_\_\_\_\_

Please indicate well location X.

ADDITIONAL INFORMATION

If more than one screen,  
show locations of each on sketch.