

TON

MISSISSIPPI BOARD OF WATER COMMISSIONERS

CODED 3 13T

WATER WELL DRILLERS LOG

J 9
28-66

Date: 3-28, 1966, Driller: Merritt Dunning Co County WINSTON

(Name)

(1) Owner of Land: Hope Well Methodists Church
(Name)

R.T. 1 - Louisville, Miss
(Address) 32 14 11

(2) Location: 1/4, 1/4, Sec. 32 T. R.
10 miles S West of Louisville
(distance) (direction) (Nearest Town)

(3) Topography: Hilly
(Hilly) (Flat) (Level)

(4) Purpose of Well: DOMESTIC
(Domestic Irrigation, Municipal, Industrial, Other)

Description & Color of Materials Sand, Clay, Red Clay, Shell, etc.	Thick- ness Feet	Depth Feet
Red SAND	0	15
PINK SAND	15	30
TAN SAND	30	32
SAND ROCK	32	33
Yellow CLAY	33	39
HARD LIGNITE	39	40
Blue CLAY	40	55
HARD GREEN CLAY	55	70
HARD ROCK	70	71
HARD yellow CLAY	71	80
SOFT yellow clay & sand	80	126
Fine Grey SAND	126	147
Grey SAND	147	178

Information upon completion of well:

(1) Diameter 2 inches.

(2) Total Depth 178 feet.

(3) Water Level 185 feet below top of ground.

(4) Cased to 168, Size 2


(5) Screen: Size 1 1/4, Length 6'

(6) Were any formations sealed against pollution?
yes, no.

If YES depth of formation _____

Why _____

Drillers Remarks: _____

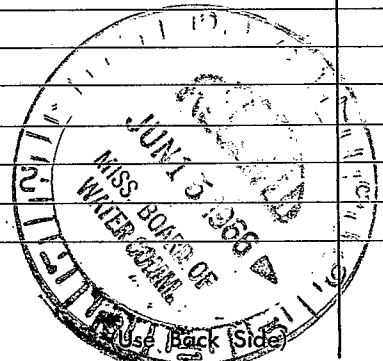

Well No.

1950

1951

1952

1953

1954

1955

1956

1957

1958

1959