

D J 10

CODED 5 13T

WATER WELL DRILLERS LOG

11-16-64

Date: 11-16, 19 64, Driller: Merritt Downing County, Winston

(Name)

(1) Owner of Land: Fred Humphries

(Name)

Rfd. 2 - Louisville

(Address)

241411

(2) Location: 1/4, 1/4, Sec. T R

5 miles West of Louisville

(distance)

(direction)

(Nearest Town)

(3) Topography: Hilly

(Hilly)

(Flat)

(Level)

(4) Purpose of Well: Domestic

(Domestic Irrigation)

(Municipal, Industrial, Other)

Description & Color of Materials  
Sand, Clay, Red Clay, Shell, etc.

Thick-  
ness  
Feet

Depth  
Feet

TOP SOIL -	6	1
Red clay	1	8
Red SAND	8	18
PINK SAND -	18	24
TAN SAND -	24	63

Information upon completion of well:

(1) Diameter 2 inches.

(2) Total Depth 63 feet.

(3) Water Level 40 feet below top of ground.

(4) Cased to 57, Size 2

(5) Screen: Size 2, Length 6


(6) Were any formations sealed against pollution?

yes,  no.

If YES depth of formation

Why

Drillers Remarks:

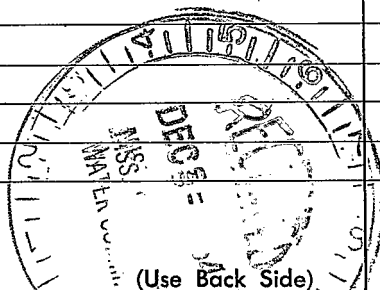

(Use Back Side)

Well No.

