

WINSTON CODED WATER WELL DRILLERS LOG

MJ13

S 13

Date: 3-5-1964, Driller: Merritt Drilling Co. County: Winston

3-5-64

(Name)

(1) Owner of Land: DAVIS O. Dickerson
 (Name)
Louisville, Miss.
 (Address)
12 14 11
 (2) Location: 1/4, 1/4, Sec. T R,
3 miles S.W. of Louisville,
 (distance) (direction) (Nearest Town)
 (3) Topography: Hilly
 (Hilly) (Flat) (Level)
 (4) Purpose of Well: Domestic
 (Domestic Irrigation
 Municipal, Industrial, Other)



Description & Color of Materials Sand, Clay, Red Clay, Shell, etc.	Thick- ness Feet	Depth Feet
TOP SOIL	0	3
Yellow CLAY	3	12
Blue Humbow	12	20
LIGNITE	20	27
Yellow CLAY	27	31
Green CLAY	31	32
Blue CLAY	32	38
GRAY CLAY	38	42
LIGNITE & CLAY	42	45
Blue CLAY	45	48
Blue SAND	46	48
Blue CLAY & LIGNITE	48	58
Blue SAND & CLAY	58	64
Blue CLAY	64	66
LIGNITE	66	74
White chalk	74	75
GREEN CLAY	75	84
ROCKY		
Blue SAND	84	94
ROCK	94	95
Blue SAND	95	168

Information upon completion of well:

(1) Diameter 2 inches,
 (2) Total Depth 168 feet.
 (3) Water Level 80 feet below top of ground.
 (4) Cased to 83, Size 2"
 (5) Screen: Size Open, Length _____
 (6) Were any formations sealed against pollution?
 _____ yes, _____ no.

If YES depth of formation Shale TRAP
 Why at 83' position

Drillers Remarks:

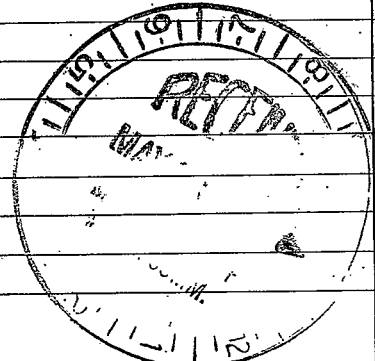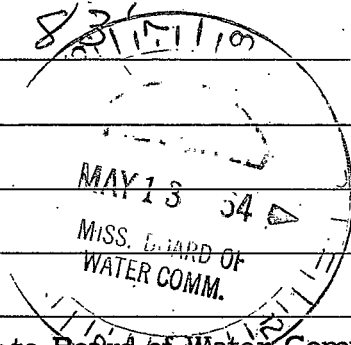

(Use Back Side)

Well No.

1918

The first part of the report
 deals with the general
 conditions of the country
 and the progress of the
 various departments.
 It is followed by a
 detailed account of the
 work done during the
 year, and a summary
 of the results.
 The report is
 divided into several
 sections, each dealing
 with a different
 aspect of the work.
 The first section
 deals with the
 general conditions
 of the country, and
 the progress of the
 various departments.
 It is followed by a
 detailed account of
 the work done during
 the year, and a
 summary of the
 results.