

Winston  
J 15  
6-5-70

MISSISSIPPI  
BOARD OF WATER COMMISSIONERS  
416 North State Street  
Jackson, Mississippi 39201

Caled  
Rtn 7/6/70  
Ret 7/10/70

WATER WELL DRILLERS LOG

6-5 1970 J H M Daniels Winston  
date well completed firm name county well located

LANDOWNER: Hinge School  
Louisville Miss  
(mailing address)

description of formations encountered	from	to
<u>Red clay</u>		<u>25</u>
<u>small 2 pipe clay</u>	<u>25</u>	<u>84</u>
<u>White sand</u>	<u>84</u>	<u>90</u>

WELL LOCATION:  
sec 31 T 14 N R 11 E  
1 1/2 - 2.5 miles SW of Louisville  
(distance) (direction) (nearest town)

WELL PURPOSE:  
(home, irrigation, municipal, industrial)

WELL COMPLETION DATA:

(1) diameter (inches) 2

(2) total depth (feet) 105 89

(3) static water level (feet) 80 below top of ground.

(4) casing 2" (material) 84' (depth)

(size) If telescope see-back.

(5) screen 5' (length) 84 (depth to top)

1 1/2 (size) 6000 (material) 53

(6) pump 1/2 (HP) 5 (yield gpm)

electric (type power)

(7) electric log No (yes or no)

(organization running log)

(8) how well bottom plugged point


JUL 2 1970

DRILLERS REMARKS:

MISS. BD. OF  
WATER COMMISSIONERS

If well telescopes please sketch and show depths.

GROUND LEVEL

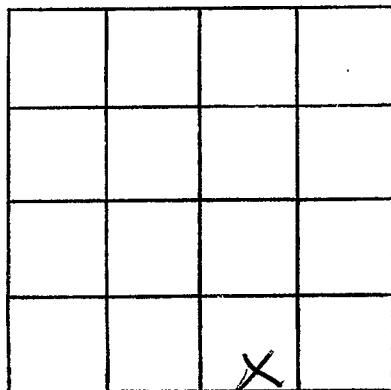

SECTION 31

Please indicate well location X.

ADDITIONAL INFORMATION

If more than one screen,  
show locations of each on sketch.