

MISSISSIPPI
BOARD OF WATER COMMISSIONERS
416 North State Street
Jackson, Mississippi 39201

CODED

WATER WELL DRILLERS LOG

Winston
J 20
1-28-70

1-28
date well completed

19 70 J H McDonald
firm name

Winston
county well located


LANDOWNER:	Description of formations encountered	from	to
<p>Suber Reynolds Louisville Miss (mailing address)</p>	red clay	0	25
	fine white sand	25	30
	lignite	30	33
	gray clay	33	60
	white sand	60	68
<p>WELL LOCATION: sec. 20 T 14 N R 11 E 1 1/2 miles SW of Louisville (distance) (direction) (nearest town)</p>			
<p>WELL PURPOSE: (home, irrigation, municipal, industrial)</p>			
<p>WELL COMPLETION DATA:</p> <p>(1) diameter (inches) 2"</p> <p>(2) total depth (feet) 68</p> <p>(3) static water level (feet) 40 below top of ground.</p> <p>(4) casing 2" (material), 63 (depth) (size) if telescope see back.</p> <p>(5) screen 4' (length), 68 (depth to top) 1 1/4" (size), 160 gpm 5.5 (material)</p> <p>(6) pump 1 (HP), 8 (yield gpm) electronic (type power)</p> <p>(7) electric log no (yes or no)</p> <p>(organization running log)</p> <p>(8) how well bottom plugged</p>			
<p>DRILLERS REMARKS:</p>			

FEB 24 1970

MISS. BD OF WATER COMMISSIONERS

If well telescopes please sketch and show depths.

GROUND LEVEL

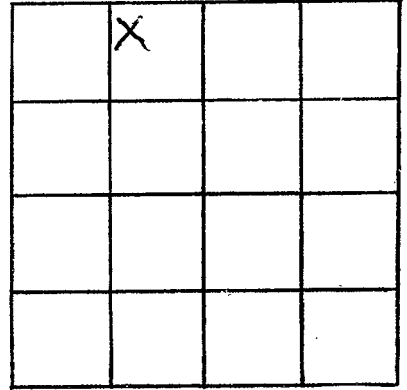

SECTION _____

Please indicate well location X.

ADDITIONAL INFORMATION

If more than one screen,
show locations of each on sketch.