

Winston
 J 21
 2-5-70

MISSISSIPPI
 BOARD OF WATER COMMISSIONERS
 416 North State Street
 Jackson, Mississippi 39201

CODED

WATER WELL DRILLERS LOG

2/5/1970 J. N. McDonald Winston
 date well completed firm name county well located

LANDOWNER	description of formations encountered	from	to
Jerry Stanley	Red clay	0	20
Sosisville, Miss.	Pice clay & sand	20	40
	White sand	40	46

(mailing address)

WELL LOCATION:

sec. 35 T 14 N R 11 E
 12 miles SW of Sosisville
 (distance) (direction) (nearest town)

WELL PURPOSE:

(home, irrigation, municipal, industrial)

WELL COMPLETION DATA:

- (1) diameter (inches) 2"
 - (2) total depth (feet) 46'
 - (3) static water level (feet) 30' below above top of ground.
 - (4) casing 42" 46'
 (material) (depth)
 (size) if telescope see back.
 - (5) screen 4' 46'
 (length) (depth to top)
1 1/4 8 slots
 (size) (material)
 - (6) pump 1/2 7
 (HP) (yield gpm)
electric
 (type power)
 - (7) electric log No
 (yes or no)
- (organization running log)

(8) how well bottom plugged


FEB 24 1970

DRILLERS REMARKS:

MISS. BD. OF
 WATER COMMISSIONERS

If well telescopes please sketch and show depths.

GROUND LEVEL

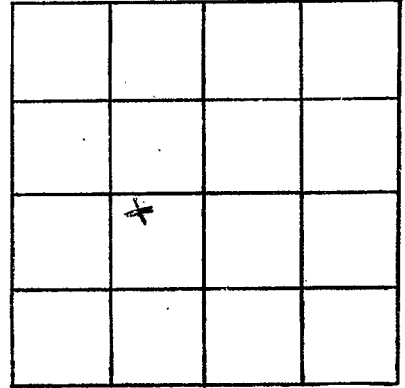

SECTION _____

Please indicate well location X.

ADDITIONAL INFORMATION

If more than one screen,
show locations of each on sketch.