

WINSTON  
J 23  
10-9-75

MISSISSIPPI  
BOARD OF WATER COMMISSIONERS  
416 North State Street  
131 Jackson, Mississippi 39201

WATER WELL DRILLERS LOG

10-9-75 date well completed  
G. H. McDonald firm name  
Winston county well located

LANDOWNER: Hinge H.S. School  
Louisville Miss.

description of formations encountered	from	to
red clay	0	20
pipe clay sand	20	80
sand & clay	80	95
red sand	95	105

(mailing address)

WELL LOCATION:  
sec. 31 T 14 N R 11 E  
S E  
10 miles SW of Louisville  
(distance) (direction) (nearest town)

WELL PURPOSE: Hand & School  
(home, irrigation, municipal, industrial)


- WELL COMPLETION DATA:
- (1) diameter (inches) 2"
  - (2) total depth (feet) 103
  - (3) static water level (feet) 80 below above top of ground.
  - (4) casing steel 96  
(material) (depth)  
2" If telescope see back.  
(size)
  - (5) screen 6' 103 97  
(length) (depth to top)  
2" 10 slot 35  
(size) (material)
  - (6) pump 1/2 HP 5  
(HP) (yield gpm)  
electric  
(type power)
  - (7) electric log no  
(yes or no)
- (organization running log)
- (8) how well bottom plugged \_\_\_\_\_

DRILLERS REMARKS:

OCT 18 1975  
MISS. Bd. OF WATER COMMISSIONERS

If well telescopes please sketch and show depths.

GROUND LEVEL

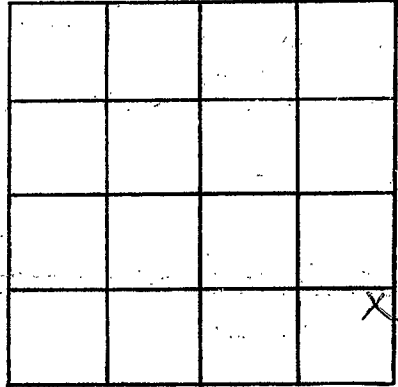

SECTION 31

Please indicate well location X.

ADDITIONAL INFORMATION

Lined area for additional information.

If more than one screen, show locations of each on sketch.