

DEPT. OF NATURAL RESOURCES
BUREAU OF LAND & WATER RESOURCES

MISSISSIPPI
BOARD OF WATER COMMISSIONERS

416 North State Street
Jackson, Mississippi 39201

WATER WELL DRILLERS LOG

WINSTON
J26
E log # 39
J 1/80

RECEIVED
JAN 28 1980
MS-GW-62038

CODED

JANUARY 1980 date well completed
HERNDON WELL & SUPPLY, INC. firm name
WINSTON CO. county well located

LANDOWNER:	description of formations encountered	from	to
CALVARY WATER ASSOCIATION, INC.	Red & White Sand	0	48
WINSTON COUNTY, MS	Sand Rock	48	49
(mailing address)	Blue Clay	49	305
WELL LOCATION:	Blue Clay with streaks of sand	305	400
sec. 14 T 14 N R 11 E	White Coarse Sand	400	438
10 miles SW of Louisville	Blue Clay with streaks of sand	438	483
(distance) (direction) (nearest town)			
WELL PURPOSE: Community			
(home, irrigation, municipal, industrial)			
WELL COMPLETION DATA:			
(1) diameter (inches) 8 X 4"			
(2) total depth (feet) 429			
(3) static water level (feet) 160 below top of ground			
(4) casing Steel 400 (material), (depth)			
400 (size) if telescope see back.			
(5) screen 30' 399 (length), (depth to top)			
4" SS (size), (material)			
(6) pump 15 150 (HP), (yield gpm)			
Elec (type power)			
(7) electric log <input checked="" type="checkbox"/> (yes or no)			
G S (organization running log)			
(8) how well bottom plugged BWV			
DRILLERS REMARKS:			


CODED

If well telescopes please sketch and show depths.

GROUND LEVEL



If more than one screen, show locations of each on sketch.

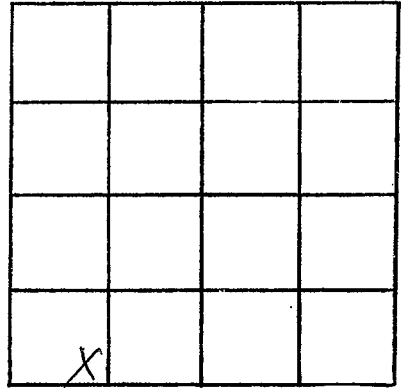

SECTION 14

Please indicate well location X.

ADDITIONAL INFORMATION

A series of horizontal lines for providing additional information.