

WINSTON

J 2000

3-28-78

MISSISSIPPI BOARD OF WATER COMMISSIONERS
416 North State Street
Jackson, Mississippi 39201

WATER WELL DRILLERS LOG

3-28 1978 of H.M. Donald Winston
date well completed firm name county well located

LANDOWNER: John Leone
Louisville Miss
(mailing address)
WELL LOCATION:
sec. 15 T 14 N R 11 E
7 miles SW of Louisville
(distance) (direction) (nearest town)

description of formations encountered	from	to
Red clay	0	20
Sand & clay	20	30
white sand	30	36


WELL PURPOSE: Home
(home, irrigation, municipal, industrial)

- WELL COMPLETION DATA:
- (1) diameter (inches) 2"
 - (2) total depth (feet) 36
 - (3) static water level (feet) 28 above top of ground
 - (4) casing PVC, 32 (material) (depth)
24 (size) if telescope see back.
 - (5) screen 4, 36+32 (length) (depth to top)
1/4" slot 55 (size) (material)
 - (6) pump 1 (HP) 4 (yield gpm)
electric (type power)
 - (7) electric log no (yes or no)

(organization running log)

(8) how well bottom plugged


DRILLERS REMARKS:

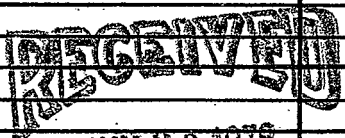

JUN 20 1978

If well telescopes please sketch and show depths.

GROUND LEVEL

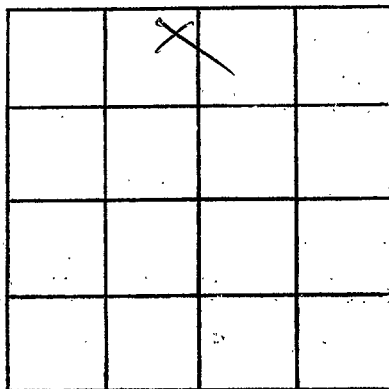

SECTION 15

Please indicate well location X.

ADDITIONAL INFORMATION

If more than one screen, show locations of each on sketch.