

MISSISSIPPI DEPARTMENT OF NATURAL RESOURCES

Bureau of Land and Water Resources

Southport Mall

P.O. Box 10631

Jackson, Mississippi 39209

WATER WELL DRILLERS LOG

WINSTON
J 2002

6-23-1989 date well completed
F.D. Commins firm name
Winston county well located

LANDOWNER:	description of formations encountered	from	to
Joella Lew	Top Soil	0	30
	Clay	10	30
	Block Shale	30	105
	Rock	105	120
	Block down	120	160
	Coarse Sand	160	190
	Coarse Sand Finer	190	230
(mailing address)			
WELL LOCATION:			
sec. 22 T14N R11E			
8 miles W of Louisville			
(distance) (direction) (nearest town)			
WELL PURPOSE:			
(home, irrigation, municipal, industrial)			
WELL COMPLETION DATA:			
(1) diameter (inches) 2"			
(2) total depth (feet) 230'			
(3) static water level (feet) 170' below top of ground.			
(4) casing 2" (material), 100' P.V.C. (depth)			
2" (size) if telescope see back.			
(5) screen 2" (length), 230' (depth to top)			
2" x 4" P.V.C. (size) (material)			
(6) pump 1 (HP), 220 (yield gpm)			
E.L.C. (type power)			
(7) electric log 1/0 (yes or no)			
Shale trap (organization running log)			
(8) how well bottom plugged			

RECEIVED

JUL 05 1989


Department of Natural Resources
Bureau of Land & Water Resources

DRILLERS REMARKS:

I have sent these log of pieces and they have come back to me please send me the right address to where the better log will go to.

If well telescopes please sketch and show depths.

GROUND LEVEL

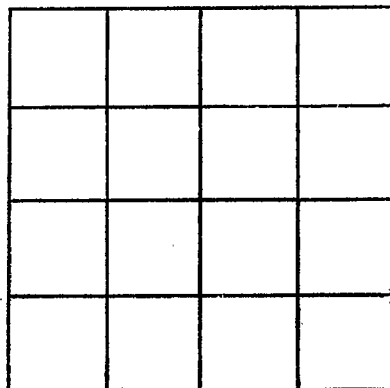

SECTION _____

Please indicate well location X.

ADDITIONAL INFORMATION

If more than one screen,
show locations of each on sketch.