

Winston

Elog # 11

MISSISSIPPI BOARD OF WATER COMMISSIONERS

K 10

CODED

3

137

12-65

WATER WELL DRILLERS LOG

Date: Dec. 4, 1965, Driller: Robert E. Ratliff County: Winston
(Name)

(1) Owner of Land: Southeast Winston Rural Water Assn.
(Name)
Louisville, Miss.
(Address)

(2) Location: SW 1/4, NE 1/4, Sec. 11 T4R12
(distance) (direction) (Nearest Town)

2 miles east, Louisville
(distance) (direction) (Nearest Town)

(3) Topography: Hilly
(Hilly) (Flat) (Level)

(4) Purpose of Well: Municipal
(Domestic Irrigation
Municipal, Industrial, Other)

Description & Color of Materials Sand, Clay, Red Clay, Shell, etc.	Thick- ness Feet	Depth Feet
<u>Clay</u>	<u>20</u>	<u>20</u>
<u>lignite + shale</u>	<u>4</u>	<u>24</u>
<u>gray clay</u>	<u>91</u>	<u>115</u>
<u>white sand</u>	<u>95</u>	<u>210</u>

Information upon completion of well:

(1) Diameter 10 inches.

(2) Total Depth 204 feet.

(3) Water Level 124'4" feet below top of ground.

(4) Cased to 174', Size 10"

(5) Screen: Size 6", Length 20'


(6) Were there any formations sealed against pollution?

L yes, no.

If YES depth of formation Cemented in place.

Why

Drillers Remarks: Well was test pumped at 160 GPM with a 12ft draw-down.

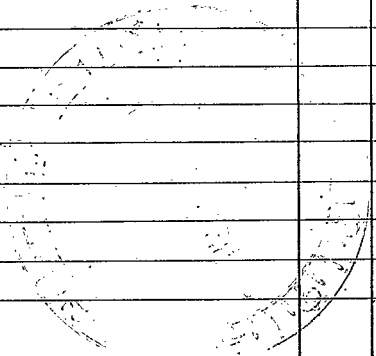

(Use Back Side)

Well No.

(X)