


CODED

MISSISSIPPI BOARD OF WATER COMMISSIONERS

416 North State Street

Jackson, Mississippi 39201

WATER WELL DRILLERS LOG

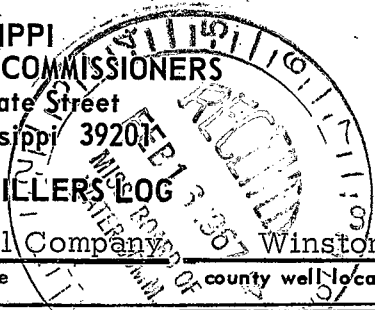

Winston  
K11  
1-67

1-31-

1967 Layne-Central Company

Winston

date well completed

firm name

county well located

LANDOWNER: Flower Ridge  
Water Association, Inc.

description of formations encountered

from to

Red Sandy Clay

0 10

(Mr. Sam E. Smith, Engineer  
Louisville, Mississippi)

Hard Streaks

10 12

(mailing address)

White Clay

12 42

WELL LOCATION: Hiway 15

Black Shale, Stks. Lignite

42 65

sec. 28 T 14 N R 12 E

Rock

65 66

5 miles South of Louisville

Shale, Streaks of lignite

66 133

(distance) (direction) (nearest town)

Hard Shale, Stks. Lignite

133 258

WELL PURPOSE: domestic

Rock

258 263

(home, irrigation, municipal, industrial)

Hard Shale, Stks. Sand

263 407

WELL COMPLETION DATA:

Sand

407 459

Tough Clay

459 465

(1) diameter (inches) 10"

(2) total depth (feet) 463'

(3) static water level (feet) 134 below top of ground.

(4) casing Steel 407' (material) (depth)

(size) if telescope see back.

(5) screen 40' 407' (length) (depth to top)

6" stainless steel (size) (material)

(6) pump 15 (HP) (yield gpm)

electric (type power)

(7) electric log no (yes or no)

(organization running log)

(8) how well bottom plugged slugs

DRILLERS REMARKS:

Pump not set & tested as of this date.

*Handwritten notes:*  
No record of well  
log on file  
12/20/67

(X)

If well telescopes please sketch and show depths.

GROUND LEVEL


SECTION \_\_\_\_\_

Please indicate well location X.

ADDITIONAL INFORMATION

If more than one screen, show locations of each on sketch.