

K 15
8-15-60

6 137
CODED WATER WELL DRILLERS LOG

Date: 8-15, 1960, Driller: J. H. McDonald County Winston
(Name)

(1) Owner of Land: Walter Mitchell
(Name)
Louisville, Miss.
(Address)

(2) Location: 7 14 12 $\frac{1}{4}$, $\frac{1}{4}$, Sec. 7 T R
3 miles S.W. of Louisville
(distance) (direction) (Nearest Town)

(3) Topography: level
(Hilly) (Flat) (Level)

(4) Purpose of Well: _____
(Domestic Irrigation
Municipal, Industrial, Other)

Description & Color of Materials Sand, Clay, Red Clay, Shell, etc.	Thick- ness Feet	Depth Feet
Blue Red Clay	20	20
Blue & Black Clay	106	126
Blue tight sand sand	34	160
Remarks - This sand has very little water in it.		

Information upon completion of well:

(1) Diameter 2 inches.

(2) Total Depth 160 feet.

(3) Water Level 126 feet below top of ground.

(4) Cased to 126, Size 2"


(5) Screen: Size open Length 1'

(6) Were any formations sealed against pollution?
_____ yes, no no.

If YES depth of formation _____

Why _____

Drillers Remarks: _____

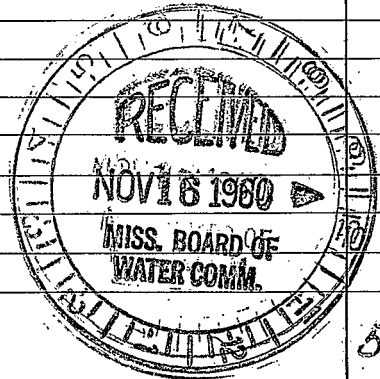

(Use Back Side)

Well No. 5

[The page contains extremely faint and illegible text, likely bleed-through from the reverse side of the document. No specific words or phrases can be discerned.]