

K18

6 13T

WATER WELL DRILLERS LOG

9-13-60

Date: 9. 13, 1960, Driller: J. H. McDonald County Winston

(Name)

- (1) Owner of Land: J. W. Johnson (Name)
Louisville, Miss. (Address)
23 14 12
- (2) Location: 1/4, 1/4, Sec. T R
6 miles S. E. of Louisville (distance) (direction) (Nearest Town)
- (3) Topography: Level (Hilly) (Flat) (Level)
- (4) Purpose of Well: Domestic (Domestic Irrigation Municipal, Industrial, Other)


Description & Color of Materials Sand, Clay, Red Clay, Shell, etc.	Thick- ness Feet	Depth Feet
Clay	20'	20'
Grey clay	100'	120'
Sand	30'	150'

Information upon completion of well:

- (1) Diameter 2 inches.
- (2) Total Depth 150 feet.
- (3) Water Level 90 feet below top of ground.
- (4) Cased to 105, Size 2"
- (5) Screen: Size 60 ga, Length 6'
- (6) Were any formations sealed against pollution?
yes, no

If YES depth of formation
Why

Drillers Remarks:

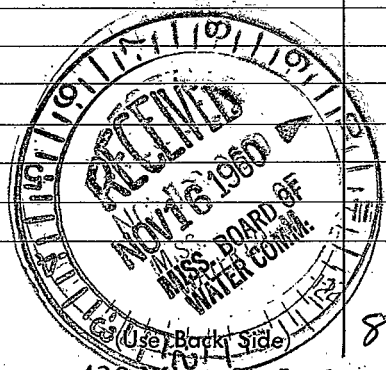

Well No. 8

