

4-14-61  
 R 19 20

6 13T

CODED

WATER WELL DRILLERS LOG

Date: 4/14, 1961, Driller: L. K. MERRITT County: WINSTON  
 (Name)

(1) Owner of Land: TIM HAYNES  
 (Name)  
R. D. Louisville Miss.  
 (Address) 25, 14 12

(2) Location: 6 miles SE, of LOUISVILLE  
 (distance) (direction) (Nearest Town)

(3) Topography:  (Hilly)  (Flat)  (Level)

(4) Purpose of Well: Domestic  
 (Domestic Irrigation, Municipal, Industrial, Other)

Description & Color of Materials Sand, Clay, Red Clay, Shell, etc.	Thick- ness Feet	Depth Feet
Hard red clay	0	7
Hard white clay	7	18
Soft light clay, trace		
to powder sand	18	27
Med. Hard blue clay	27	32
4" Rock at 32'		
Hard blue clay	32	43
4" Rock at 43'		
Blue clay	43	44
6" Rock at 44'		
Med. Hard blue clay	44	61
Med. Hard lignite	61	73
Dark clay (Med. Hard)	73	86
Med. soft lignite	86	90
Med. soft grey clay		
Trace of powder sand	90	110
Med. Hard grey clay	110	120
Soft grey clay	120	132
Fine powder sand, Mud + silt	132	167

Information upon completion of well:

(1) Diameter 2 inches.

(2) Total Depth 167 feet.

(3) Water Level 61 feet below top of ground.

(4) Cased to 84, Size 2


(5) Screen: Size open, Length \_\_\_\_\_

(6) Were any formations sealed against pollution?  
 yes,  no.

If YES depth of formation 84'

Why 2 shoe traps to

Drillers Remarks: Prevent Hole from  
filling below casing -

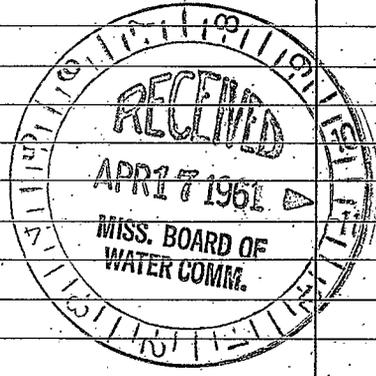

(Use Back Side)

Well No.

