

WINSTON

K 24

5-9-74

MISSISSIPPI BOARD OF WATER COMMISSIONERS
416 North State Street
Jackson, Mississippi 39201

CODED

WATER WELL DRILLERS LOG

5-9 19
date well completed

749 Haney Dr
firm name

Winston
county well located

LANDOWNER: Louisville
County Club
Louisville

description of formations encountered

from to

Clay

0 20

(mailing address)

gray clay

20 110

WELL LOCATION:

sec 10 T 14 N R 12 E

gray fine sand

110 160

2 miles south of Louisville
(distance) (direction) (nearest town)

gray clay

160 310

WELL PURPOSE: County Club
(home, irrigation, municipal, industrial)

fine sand

310 350

WELL COMPLETION DATA:

coarse sand

350 380

(1) diameter (inches) 4"

(2) total depth (feet) 370

(3) static water level (feet) 120 below top of ground.

(4) casing steel 231 (material) (depth)

4" (size) if telescope see back.

(5) screen 20' 370-350 (length) (depth to top)

2" SS-12 slot (size) (material)

(6) pump 3 50 (HP) (yield gpm)

electric (type power)

(7) electric log (yes or no)

(organization running log)

(8) how well bottom plugged

CODED

RECEIVED
MAY 20 1974

DRILLERS REMARKS:

MISS. BD. OF WATER COMMISSIONERS

If well telescopes please sketch and show depths.

GROUND LEVEL




231'
4" pipe



120'
2" pipe



20'
2"
1/8" point

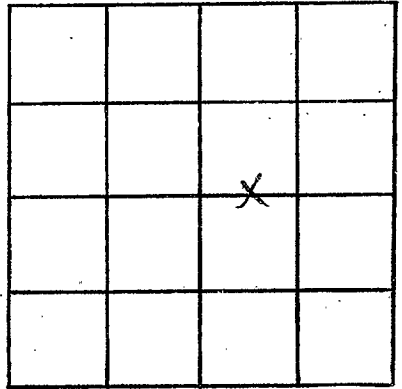

SECTION 10

Please indicate well location X.

ADDITIONAL INFORMATION

If more than one screen, show locations of each on sketch.