

WINSTON
K 25
12-5-78
E Log # 33

MISSISSIPPI
BOARD OF WATER COMMISSIONERS
416 North State Street
Jackson, Mississippi 39201

CODED

WATER WELL DRILLERS LOG

5 December 1978 Herndon Well & Supply, Inc. Winston
date well completed firm name county well located

LANDOWNER: Flower Ridge Water Association, Inc.
Louisville, MS
(mailing address)

description of formations encountered	from	to
Red Clay	0	5
White Chalk	5	15
Black Clay (Lignite)	15	40
Sandy Clay (green)	40	95
Black Clay	95	110
Sandy Clay	110	130
Sand	130	150
Sandy Clay	150	195
Sand	195	225
Clay	225	232
Sand	232	250
Sandy Clay	250	300
Sand	300	312
Clay	312	316
Sand	316	325
Clay	325	333
Sand	333	380
Clay	380	398
Sand	398	458
Clay	458	461
Sand	461	490
Clay	490	504

WELL LOCATION:
sec. 28 T14 N R 12 E
4 miles South of Louisville
(distance) (direction) (nearest town)

WELL PURPOSE: Municipal
(home, irrigation, municipal, industrial)

WELL COMPLETION DATA:
(1) diameter (inches) 8 x 4
(2) total depth (feet) 445'
(3) static water level (feet) 136 below top of ground.
(4) casing Steel, 405' (material), (depth)
8" if telescope see back. (size)
(5) screen 40' length, 442' depth to top
4" Stainless-Ribbed (size), (material)
(6) pump 15 HP, 183 (yield gpm)
Electric (type power)
(7) electric log Yes (yes or no)
MS Geo. Survey (organization running log)
(8) how well bottom plugged 4" BWV

CODED


RECEIVED
DEC 11 1978
MISS. BD. OF WATER COMM.

DRILLERS REMARKS:

⑦

If well telescopes please sketch and show depths.

GROUND LEVEL

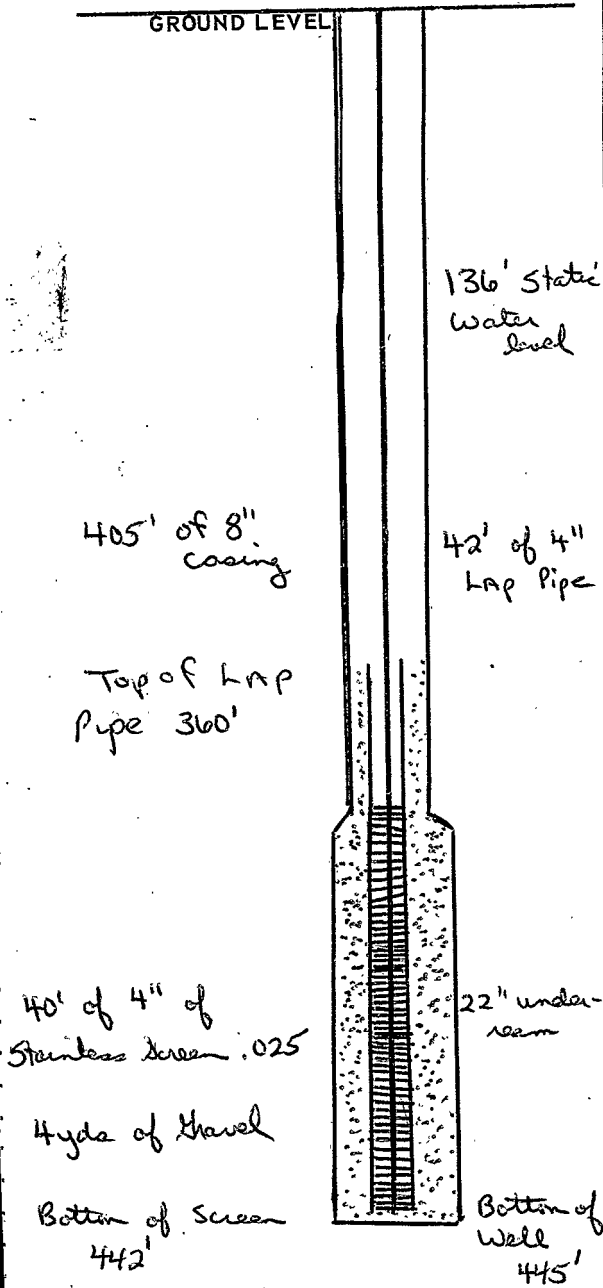

405' of 8" casing

Top of LRP Pipe 360'

40' of 4" of stainless screen .025

4 yds of gravel

Bottom of Screen 442'

136' static water level

42' of 4" LRP Pipe

22" under-ream

Bottom of Well 445'

		X	

SECTION 28

Please indicate well location X.

ADDITIONAL INFORMATION

If more than one screen, show locations of each on sketch.