

**MISSISSIPPI DEPARTMENT OF NATURAL RESOURCES**  
**Bureau of Land and Water Resources**  
 Southport Mall  
 P.O. Box 10631  
 Jackson, Mississippi 39209  
**WATER WELL DRILLERS LOG**

Winston  
K 28  
7-14-89

*Coded*

07/14/89 19 LAYNE-CENTRAL COMPANY Winston  
 date well completed firm name county well located

LANDOWNER:	description of formations encountered	from	to
<u>Louisville Utility</u>			
<u>Post Office Box 223</u>	<u>Red Clay</u>	<u>0</u>	<u>20</u>
<u>Louisville, Ms. 39339</u>	<u>Blue Clay</u>	<u>20</u>	<u>40</u>
<u>(mailing address)</u>	<u>Clay &amp; Lignite</u>	<u>40</u>	<u>62</u>
<b>WELL LOCATION:</b>	<u>Clay</u>	<u>62</u>	<u>150</u>
<u>sec. 3 T 14 N R 12 E</u>	<u>Sandy Clay</u>	<u>150</u>	<u>160</u>
<u>W</u>	<u>Clay</u>	<u>160</u>	<u>220</u>
<u>_____ miles _____ of _____</u>	<u>Sandy Clay</u>	<u>220</u>	<u>261</u>
<u>(distance) (direction) (nearest town)</u>	<u>Sand</u>	<u>261</u>	<u>315</u>
<b>WELL PURPOSE:</b>	<u>Clay</u>	<u>315</u>	<u>323</u>
<u>Municipality</u>	<u>Sand &amp; Clay Streaks</u>	<u>323</u>	<u>340</u>
<u>(home, irrigation, municipal, industrial)</u>			
<b>WELL COMPLETION DATA:</b>			
(1) diameter (inches) <u>18"</u>			
(2) total depth (feet) <u>316'</u>			
(3) static water level (feet) <u>119'</u> below above top of ground.			
(4) casing <u>Steel</u> , <u>262'</u>			
<u>(material) (depth)</u>			
<u>N/A</u> if telescope see back.			
<u>(size)</u>			
(5) screen <u>50'</u> , <u>264'</u>			
<u>(length) (depth to top)</u>			
<u>10"</u> , <u>Stainless Steel</u>			
<u>(size) (material)</u>			
(6) pump <u>60</u> <u>750</u>			
<u>(HP) (yield gpm)</u>			
<u>Electrical</u>			
<u>(type power)</u>			
(7) electric log <u>Yes</u>			
<u>(yes or no)</u>			
<u>Layne-Central Company</u>			
<u>(organization running log)</u>			
(8) how well bottom plugged <u>Stainless</u>			
<u>Steel Flat Bottom</u>			

*6/10  
5/14*

**RECEIVED**  
**RECEIVED**


**JAN 22 1990**

Department of Natural Resources  
 Bureau of Land & Water Resources

**DRILLERS REMARKS:**  
12" P.V.C. Lap brought to surface

If well telescopes please  
sketch and show depths.

GROUND LEVEL

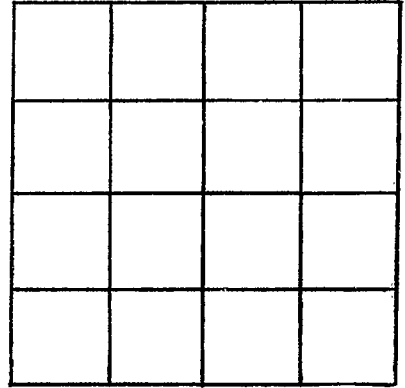

SECTION \_\_\_\_\_

Please indicate well location X.

ADDITIONAL INFORMATION

If more than one screen,  
show locations of each on sketch.