

4

6 136

CODED

WATER WELL DRILLERS LOG

10-14-60

Date: 10-14, 1960, Driller: F. H. McDonald County Winston

(Name)

(1) Owner of Land: W. Pandal Sullivan (Name)

Louisville, Miss (Address) 13 14 13

(2) Location: 1/4, 1/4, Sec. T R

9 miles East of Louisville (distance) (direction) (Nearest Town)

(3) Topography: Level (Hilly) (Flat) (Level)

(4) Purpose of Well: Domestic (Domestic Irrigation Municipal, Industrial, Other)

Description & Color of Materials Sand, Clay, Red Clay, Shell, etc.	Thick- ness Feet	Depth Feet
Grey Clay	20'	20'
fine sand & clay	20'	40'
finer sand	10'	50'

Information upon completion of well:

(1) Diameter 2 inches.

(2) Total Depth 50 feet.

(3) Water Level 20 feet below top of ground.

(4) Cased to 45', Size 2"

(5) Screen: Size 1 1/4" 90 ga., Length 5 ft.


(6) Were any formations sealed against pollution?

yes, no no.

If YES depth of formation

Why

Drillers Remarks:

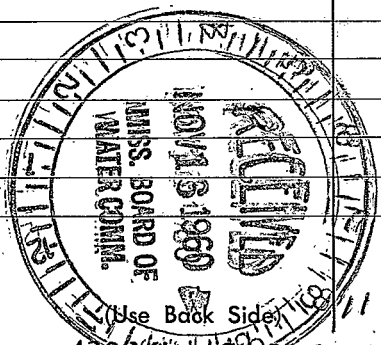

Well No.

[The page contains extremely faint and illegible text, likely bleed-through from the reverse side of the document. No specific words or phrases can be discerned.]