

MISSISSIPPI BOARD OF WATER COMMISSIONERS

WATER WELL DRILLERS LOG

CODED

Date: 7 8, 1960, Driller: J. H. McDonald County Winston
 (Name)


(1) Owner of Land: Iruman Calloway
 (Name)
#3 Louisville, Miss.
 (Address)
 Location: 7 14 13 T R
 _____ miles _____ of _____
 (distance) (direction) (Nearest Town)
 (3) Topography: Level
 (Hilly) (Flat) (Level)
 (4) Purpose of Well: Domestic
 (Domestic Irrigation
 Municipal, Industrial, Other)

Description & Color of Materials Sand, Clay, Red Clay, Shell, etc.	Thick- ness Feet	Depth Feet
<u>Red Clay</u>	<u>15 ft</u>	<u>15 ft</u>
<u>Blue Clay</u>	<u>45 ft</u>	<u>60</u>
<u>Lignite</u>	<u>10 ft</u>	<u>70</u>
<u>Blue Clay</u>	<u>50 ft</u>	<u>120</u>
<u>Fine gray sand</u>	<u>15 ft</u>	<u>135</u>

Information upon completion of well:

(1) Diameter 2 inches.
 (2) Total Depth 135 feet.
 (3) Water Level 100 feet below top of ground.
 (4) Cased to 124 ft, Size 2"
 (5) Screen: Size 90 gage length 10 ft.
 (6) Were any formations sealed against pollution?
 _____ yes, No no.

Remarks -
Stopped well
on rock at
135 ft. put
washed coarse
sand around
outside of
screen

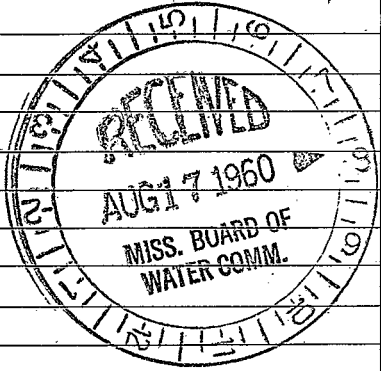

If YES depth of formation _____
 Why _____
 Drillers Remarks: _____

(Use Back Side)

Well No. I

