

L7
8-26-62

WATER WELL DRILLERS LOG

Date: 8/26, 1962 Driller: E. K. Murrell County: Winston
(Name)


(1) Owner of Land: Wayle Hall Higginson
(Name)
Laurieville, Miss
(Address)
18 14 13
(2) Location: 1/4, 1/4, Sec. 18 T. R
5 miles E of Laurieville
(distance) (direction) (Nearest Town)
(3) Topography: (Hilly) (Flat) (Level) 1
(4) Purpose of Well: Domestic
(Domestic Irrigation
Municipal, Industrial, Other)

Description & Color of Materials Sand, Clay, Red Clay, Shell, etc.	Thick- ness Feet	Depth Feet
<u>Orange Clay</u>	<u>0</u>	<u>12</u>
<u>Med. Hard Blue Clay</u>	<u>12</u>	<u>27</u>
<u>Dark Soft Clay</u>	<u>27</u>	<u>60</u>
<u>3" Rock at 40'</u>		
<u>Soft Clay, trace of</u>	<u>40</u>	<u>64</u>
<u>powder sand</u>		
<u>3" Rock at 64'</u>		
<u>Med Hard Dnk Clay</u>	<u>64</u>	<u>68</u>
<u>Hard Lignite!</u>	<u>68</u>	<u>77</u>
<u>Soft Dark Clay</u>		
<u>Trace of Tan Clay</u>	<u>77</u>	<u>132</u>
<u>Med. Hard Dnk Clay</u>	<u>132</u>	<u>142</u>
<u>Soft blue clay</u>	<u>142</u>	<u>150</u>
<u>Med. Hard blue clay</u>	<u>150</u>	<u>162</u>
<u>Soft blue clay</u>	<u>162</u>	<u>171</u>
<u>Soft Clay & powder sand</u>	<u>175</u>	<u>183</u>
<u>Med. Hard Clay</u>	<u>183</u>	<u>187</u>
<u>Hard blue clay</u>	<u>187</u>	<u>193</u>
<u>2" Rock at 193</u>		
<u>Soft Lt. grey clay</u>	<u>193</u>	<u>196</u>
<u>10" Rock at 196</u>		
<u>Hard blue clay</u>	<u>196</u>	<u>277</u>
<u>Soft Clay & sand</u>	<u>277</u>	<u>280</u>
<u>Med. Colored sand</u>	<u>280</u>	<u>290</u>
<u>dirt & mica</u>		

Information upon completion of well:

(1) Diameter 2 inches.
(2) Total Depth 290 feet.
(3) Water Level 105 feet below top of ground.
(4) Cased to 283, Size 2
(5) Screen: Size 1/4, Length 6
(6) Were any formations sealed against pollution?
yes, no.

If YES depth of formation _____
Why _____
Drillers Remarks: _____

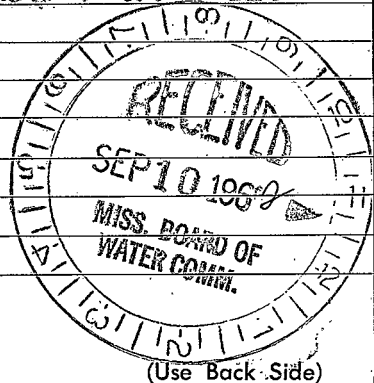

Well No.

