

Winston
L9
5-19-70

MISSISSIPPI
BOARD OF WATER COMMISSIONERS
416 North State Street
Jackson, Mississippi 39201

Coded

WATER WELL DRILLERS LOG

5-19 1970 JHM Parallel Winston
date well completed firm name county well located

LANDOWNER: Leroy Liddle
Louisville Miss
(mailing address)

description of formations encountered	from	to
Ray clay	0	15
Red sand & clay	15	32
White sand	32	45

WELL LOCATION:
sec. 10 T14N R13E
6 miles S.E. of Louisville
(distance) (direction) (nearest town)

WELL PURPOSE:
(home, irrigation, municipal, industrial)

WELL COMPLETION DATA:

(1) diameter (inches) 2

(2) total depth (feet) 45

(3) static water level (feet) 32 below above top of ground.

(4) casing 2 40 (material) (depth)
(size) If telescope see back.

(5) screen 5" 60-90 (length) (depth to top)
5 1/4 55-160 90 (size) (material)

(6) pump 1 7 (HP) (yield gpm)
electric (type power)

(7) electric log (yes or no)
(organization running log)

(8) how well bottom plugged


JUL 2 1970

DRILLERS REMARKS:

MISS. BD. OF
WATER COMM.

If well telescopes please sketch and show depths.

GROUND LEVEL

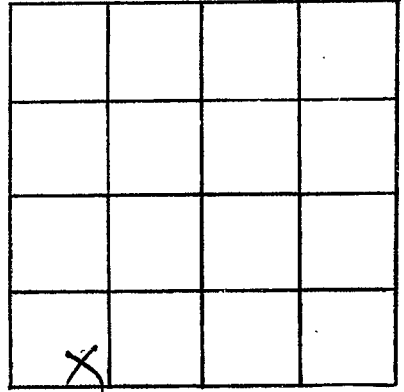

SECTION 10

Please indicate well location X.

ADDITIONAL INFORMATION

If more than one screen,
show locations of each on sketch.