

WINSTON  
L 10  
T-23-75

MISSISSIPPI  
BOARD OF WATER COMMISSIONERS  
416 North State Street  
Jackson, Mississippi 39201

WATER WELL DRILLERS LOG

7-23 1975 *J. H. McDonald* *Winston*  
date well completed firm name county well located

LANDOWNER: *Benny C Kirk*  
*Louisville Miss*  
(mailing address)  
WELL LOCATION:  
sec. *16 T 14 N* R. *13 E*  
*5 1/2* miles *SE* of *Louisville*  
(distance) (direction) (nearest town)

description of formations encountered	from	to
<i>red clay</i>	<i>0</i>	<i>6</i>
<i>pipe clay</i>	<i>6</i>	<i>20</i>
<i>lignite</i>	<i>20</i>	<i>30</i>
<i>gray clay</i>	<i>30</i>	<i>50</i>
<i>sand</i>	<i>50</i>	<i>57</i>

WELL PURPOSE: *Industrial*  
(home, irrigation, municipal, industrial)


- WELL COMPLETION DATA:
- (1) diameter (inches) *2"*
  - (2) total depth (feet) *57*
  - (3) static water level (feet) *30* below top of ground
  - (4) casing *Steel*, *52*  
(material) (depth)  
*2"* if telescope see back.  
(size)
  - (5) screen *5'*, *57* *52*  
(length) (depth to top)  
*1/4" 8 slot SS*  
(size) (material)
  - (6) pump *3/4*, *5*  
(HP) (yield gpm)  
*electric*  
(type power)
  - (7) electric log *no.*  
(yes or no)
  - (organization running log)
  - (8) how well bottom plugged

DRILLERS REMARKS:

RECEIVED  
JUL 26 1975  
MISS. BLD. OF WATER

If well telescopes please sketch and show depths.

GROUND LEVEL

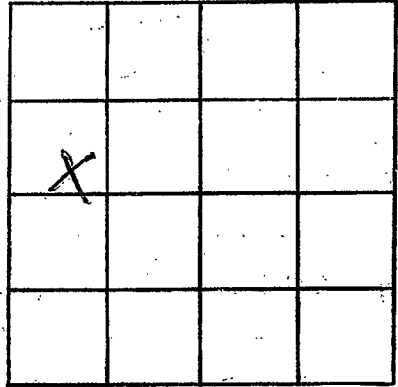

SECTION 16

Please indicate well location X.

ADDITIONAL INFORMATION

If more than one screen,  
show locations of each on sketch.