

L 13

6 13T

11-29-62

WATER WELL DRILLERS LOG

Date: 11-29, 1962, Driller: J.L. Merritt County WINSTON.

(Name)

(1) Owner of Land: W.B. Hephill (Name)

RT. 5 (Address) 11 14 13

(2) Location: 1/4, 1/4, Sec. T R

7 miles South East of Lumberton (distance) (direction) (Nearest Town)

(3) Topography: Hilly (Hilly) (Flat) (Level)

(4) Purpose of Well: Domestic (Domestic Irrigation Municipal, Industrial, Other)

Description & Color of Materials Sand, Clay, Red Clay, Shell, etc.

Thickness Feet

Depth Feet

Red clay	8	18
Lignite	18	23
White clay	23	52
Blue clay	52	65
White sand	65	105


Information upon completion of well:

- (1) Diameter 2" inches.
- (2) Total Depth 110 feet.
- (3) Water Level _____ feet below top of ground.
- (4) Cased to 105, Size 2"
- (5) Screen: Size 2", Length 6 ft.
- (6) Were any formations sealed against pollution? _____ yes, no.

If YES depth of formation _____

Why _____

Drillers Remarks: _____

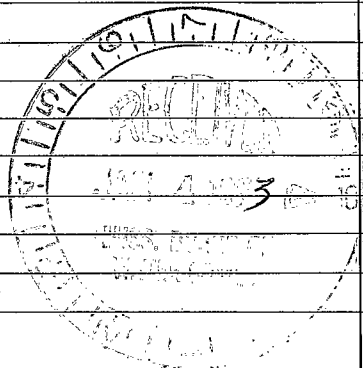

(Use Back Side)

Well No.

