

L 16

6 135

CODED

WATER WELL DRILLERS LOG

12-21-65

Date: 12-21, 1965, Driller: MERRITT DANLING CO. County WINSTON  
 (Name)

(1) Owner of Land: Guine Liden  
 (Name)

RT #4 - Louisville, Miss  
 (Address)

(2) Location: 3 14 13  
 (distance) (direction) (Nearest Town)

5 miles S.E., of Louisville  
 (distance) (direction) (Nearest Town)

(3) Topography: Hilly  
 (Hilly) (Flat) (Level)

(4) Purpose of Well: DOMESTIC  
 (Domestic Irrigation  
 Municipal, Industrial, Other)

Description & Color of Materials Sand, Clay, Red Clay, Shell, etc.	Thick- ness Feet	Depth Feet
<u>Red clay</u>	<u>0</u>	<u>10</u>
<u>TAN SAND</u>	<u>18</u>	<u>26</u>
<u>PINK SAND &amp; clay</u>	<u>26</u>	<u>38</u>
<u>Yellow clay</u>	<u>38</u>	<u>58</u>
<u>White sand</u>	<u>58</u>	<u>70</u>

Information upon completion of well:

(1) Diameter 2 inches.

(2) Total Depth 70 feet.

(3) Water Level 45 feet below top of ground.

(4) Cased to 63, Size 2

(5) Screen: Size 1 1/4, Length 5


(6) Were any formations sealed against pollution?

       yes,        no.

If YES depth of formation       

Why       

Drillers Remarks:       

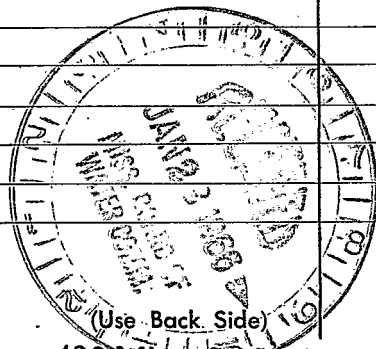

(Use Back Side)

Well No.

