

WINSTON
L 17
11-67

MISSISSIPPI
BOARD OF WATER COMMISSIONERS
416 North State Street
Jackson, Mississippi 39201

WATER WELL DRILLERS LOG

11-29 1967 J. A. McDonald Winston
date well completed firm name county well located

LANDOWNER:
James Johnson
(mailing address)

description of formations encountered	from	to
<u>Red clay</u>	<u>0'</u>	<u>20'</u>
<u>White clay</u>	<u>20'</u>	<u>60'</u>
<u>Black lignite</u>	<u>60'</u>	<u>65'</u>
<u>Gray clay</u>	<u>65'</u>	<u>75'</u>
<u>Sand & shale</u>	<u>75'</u>	<u>84'</u>

WELL LOCATION:
sec. 11 T. 14 N. R. 13 E.
6 1/2 miles SE of Spicewood
(distance) (direction) (nearest town)

WELL PURPOSE: HOME
(home, irrigation, municipal, industrial)

- WELL COMPLETION DATA:
- (1) diameter (inches) 2"
 - (2) total depth (feet) 84'
 - (3) static water level (feet) 50 below above top of ground.
 - (4) casing 4 1/2", 2"
(material) (depth)
NONE if telescope see back.
(size)
 - (5) screen 4', 8 ft
(length) (depth to top)
1/2", 5' standard
(size) (material)
 - (6) pump 1 HP 6
(HP) (yield gpm)
Electric
(type power)
 - (7) electric log NO
(yes or no)
 - (8) how well bottom plugged _____
(organization running log)


MAY 10 1968

MISS. BD. OF
WATER COMMISSIONERS

DRILLERS REMARKS:

If well telescopes please sketch and show depths.

GROUND LEVEL

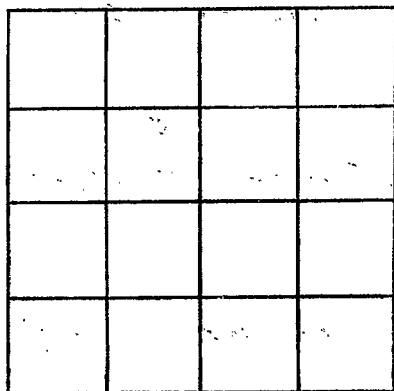

SECTION _____

Please indicate well location X.

ADDITIONAL INFORMATION

If more than one screen, show locations of each on sketch.