

WINSTON

L 18

7-31-69

MISSISSIPPI
 BOARD OF WATER COMMISSIONERS
 416 North State Street
 Jackson, Mississippi 39201

CODED

WATER WELL DRILLERS LOG

7-31-69
date well completed

J. H. McDonald
firm name

Winston
county well located

LANDOWNER: George Foster

Route 4

Louisville Miss
(mailing address)

WELL LOCATION:

sec. 26 T. 14 N. R. 13 E.

9 miles SE Louisville
(distance) (direction) (nearest town)

WELL PURPOSE: Home
(home, irrigation, municipal, industrial)

WELL COMPLETION DATA:

- (1) diameter (inches) 2"
- (2) total depth (feet) 94
- (3) static water level (feet) 50 below top of ground.

(4) casing (material) 90 (depth)

2" if telescope see back.
(size)

(5) screen 1 1/2' 4'
(length) (depth to top)

8 slot 5/16" S
(size) (material)

(6) pump 1 9
(HP) (yield gpm)

electric
(type power)

(7) electric log 90
(yes or no)

(organization running log)

(8) how well bottom plugged

description of formations encountered

from to

red clay	70	70
gray clay	70	80
white sand	80	94


DRILLERS REMARKS:

OCT 31 1969

MISS. Bd. of WATER COM.

If well telescopes please sketch and show depths.

GROUND LEVEL

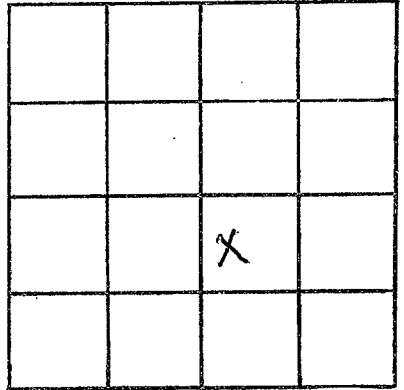

SECTION 26

Please indicate well location X.

ADDITIONAL INFORMATION

If more than one screen, show locations of each on sketch.