

089 00 21
33 02 02 N

MISSISSIPPI
BOARD OF WATER COMMISSIONERS
416 North State Street
Jackson, Mississippi 39201

CODED

WATER WELL DRILLERS LOG

Winston Co
L19
2-13-70

2/13 1970 J. H. McDonald Winston
date well completed firm name county well located

LANDOWNER: Henry Ducom
Sousville, Miss.
(mailing address)

description of formations encountered	from	to
Red Clay	0	22
Blue Clay	22	105
Fine Sandy Sand	105	125
Fair Sandy Sand	125	136

WELL LOCATION:
sec 30 T14 N R13 E
7 miles SE of Louisville
(distance) (direction) (nearest town)

WELL PURPOSE:
(home, irrigation, municipal, industrial)

- WELL COMPLETION DATA:
- (1) diameter (inches) 2"
 - (2) total depth (feet) 136'
 - (3) static water level (feet) 120' below top of ground
 - (4) casing 2' (material) 126' (depth)
 - (size) if telescope see back.
 - (5) screen 5' (length) (depth to top)
 - 1 1/4" (size) (material) (60 gm. ss.)
 - (6) pump 1/2 hp 4 gal (type power) (yield gpm)
 - electric
 - (7) electric log No (yes or no)

CODED

(organization running log)

APR 22 1970


(8) how well bottom plugged

DRILLERS REMARKS:

MISS. BD. OF
WATER COMMISSIONERS

If well telescopes please sketch and show depths.

GROUND LEVEL

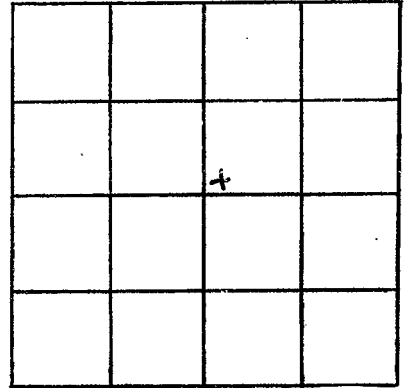

SECTION 30

Please indicate well location X.

ADDITIONAL INFORMATION

If more than one screen,
show locations of each on sketch.