

WENSTON

MISSISSIPPI
BOARD OF WATER COMMISSIONERS
416 North State Street
Jackson, Mississippi 39201

WATER WELL DRILLERS LOG

L 2001

2-19-80

date well completed 2-19 1980 firm name J H McDonald county well located Wenston


LANDOWNER: <u>Allen Heastren</u>	description of formations encountered	from	to
<u>Louisville Miss</u>			
(mailing address)	<u>clay</u>	<u>0</u>	<u>12</u>
WELL LOCATION: sec <u>13</u> T <u>14</u> (N) R <u>13</u> (E) S W <u>7</u> miles <u>SE</u> of <u>Louisville</u> (distance) (direction) (nearest town)	<u>sand</u>	<u>22</u>	<u>30</u>
WELL PURPOSE: <u>Home</u> (home, irrigation, municipal, industrial)			
WELL COMPLETION DATA:			
(1) diameter (inches) <u>2"</u>			
(2) total depth (feet) <u>30</u>			
(3) static water level (feet) <u>16</u> above top of ground.			
(4) casing <u>PVC</u> (material) <u>25'</u> (depth) <u>2"</u> (size) if telescope see back.			
(5) screen <u>5'</u> (length) <u>30-25'</u> (depth to top) <u>1 1/4" 60 gpm</u> (size) <u>59</u> (material)			
(6) pump <u>1</u> (HP) <u>4</u> (yield gpm) <u>electric</u> (type power)			
(7) electric log (yes or no) _____ (organization running log) _____			
(8) how well bottom plugged _____ <u>BW</u>			
DRILLERS REMARKS: _____			

DEPT. OF NATURAL RESOURCES
BUREAU OF LAND & WATER RESOURCES

JUL 30 1980
RECEIVED

If well telescopes please sketch and show depths.

GROUND LEVEL

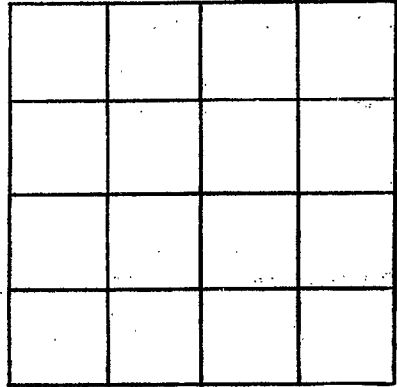

SECTION _____

Please indicate well location X.

ADDITIONAL INFORMATION

If more than one screen, show locations of each on sketch.