

MISSISSIPPI DEPARTMENT OF ENVIRONMENTAL QUALITY

Office of Land and Water Resources

P. O. Box 10631
Jackson, MS 39289-0631
WATER WELL DRILLERS LOG

COUNTY, WELL LOCATED <i>Winston</i>	
WELL NUMBER <i>L-2003</i>	CODED
DATE WELL COMPLETED <i>7-14-00</i>	

PERMIT NUMBER
NAME OF DRILLING FIRM <i>Tim's Well & Pump Service</i>

NAME & MAILING ADDRESS OF LANDOWNER <i>James Barnhill Louisville MS</i>			
WELL LOCATION:	SEC <i>3</i>	TOWNSHIP <i>14</i>	RANGE <i>N 13 E</i>
DISTANCE <i>5</i> Miles	DIRECTION <i>East</i>	NEAREST TOWN <i>of Louisville</i>	
OTHER LANDMARK <i>1/4 mi south of community well</i>			
WELL PURPOSE: Home, Irrigation, Municipal, Industrial, Fish Pond, etc.			

PUMP DATA		
PUMP TYPE (Circle One): <input checked="" type="radio"/> Submersible, <input type="radio"/> Turbine, <input type="radio"/> Jet, <input type="radio"/> Flowing Well, Other (Describe) _____		
POWER TYPE (Circle One): <input checked="" type="radio"/> Electric, <input type="radio"/> Tractor, <input type="radio"/> Diesel, <input type="radio"/> Gasoline, <input type="radio"/> Butane, Other (Describe) _____ H/P <i>1.5</i>		
Pump Capacity (GPM) <i>20</i>	No. of Stages <i>15</i>	Setting Depth <i>210</i> FT.
PUMP TEST		
Well yielded _____ GPM with a drawdown of _____ ft. after _____ hours of pumping		

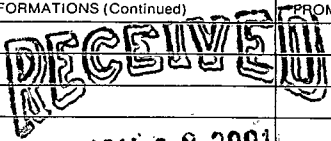
WELL DATA		
Well Depth <i>240</i>	Casing Diameter (In.) <i>4"</i>	Casing Length (Ft.) <i>220'</i>
Type of Casing <i>PVC</i>	Hole Depth <i>240'</i>	Depth to Static Water Level <i>60'</i>
TYPE OF COMPLETION: (Circle One or More): <input checked="" type="radio"/> Gravel Packed, <input type="radio"/> Underreamed, <input type="radio"/> Telescoped, <input type="radio"/> Natural Development, <input type="radio"/> Open Hole, <input type="radio"/> Other (Describe) _____		

LOG DATA	
TYPE OF LOG RUN (Circle One): <input type="radio"/> No Log Run, <input type="radio"/> Electric, <input type="radio"/> Gamma Ray, <input type="radio"/> Density, <input type="radio"/> Sonic, <input type="radio"/> Neutron, Other (Describe) _____	
Name of Organization Running Log	

WELL GROUTED TO A DEPTH OF <i>4</i> FEET Type Grout (circle one) <input checked="" type="radio"/> Cement, <input type="radio"/> Bentonite, or Mix
--

GEOLOGIC DATA (Office Use Only)			
Surface Elev.	Geologic Unit	Unit Thickness	Depth to Top
Subs. SWL	Date	Analysis	Aquifer Test
Driller's Remarks			
Top of Lap Pipe or Reduction in Casing			
FEET		IF TELESCOPED OR MORE THAN ONE SCREEN: USE BACK PAGE	

SCREEN DATA		
Diameter - Inches <i>4</i>	Length - Feet <i>20</i>	Slot Size - Inches <i>.010</i>
Screen Type <i>PVC</i>	Depth to Bottom, Feet <i>240'</i>	

DESCRIPTION OF FORMATIONS ENCOUNTERED	FROM	TO	FORMATIONS (Continued)	FROM	TO
<i>Red Sand & clay</i>	<i>0</i>	<i>25</i>	 JAN 22 2001 Dept. of Environmental Quality Office of Land & Water Resources		
<i>Pink & white clay</i>	<i>25</i>	<i>65</i>			
<i>lighte</i>	<i>65</i>	<i>70</i>			
<i>clay in small layers</i>	<i>70</i>	<i>85</i>			
<i>clay</i>	<i>85</i>	<i>105</i>			
<i>silty sand & clay</i>	<i>105</i>	<i>145</i>			
<i>coarse sand</i>	<i>145</i>	<i>240</i>			

IF MORE SPACE IS NEEDED, USE BACK

