

FM6
9-2-64

S 13 T

WATER WELL DRILLERS LOG

Date: 9-2, 1964, Driller: MERRITT DRILLING Co. County WINSTON

(Name)

(1) Owner of Land: Walter White

(Name)

Description & Color of Materials
Sand, Clay, Red Clay, Shell, etc.

Thick-
ness
Feet

Depth
Feet

Red clay + sand
White sand
Rock -

0 15
15 73
73

PT. 4-Louisville, Miss

(Address)

(2) Location: 1/4, 1/4, Sec. T R

9 miles EAST of Louisville

(distance)

(direction)

(Nearest Town)

(3) Topography: (Hilly) (Flat) (Level)

(4) Purpose of Well: Domestic

(Domestic Irrigation
Municipal, Industrial, Other)

Information upon completion of well:

(1) Diameter 2 inches.

(2) Total Depth 73 feet.

(3) Water Level 50 feet below top of ground.

(4) Cased to 63, Size 2"

(5) Screen: Size 2", Length 6'


(6) Were any formations sealed against pollution?

yes, no.

If YES depth of formation

Why

Drillers Remarks:

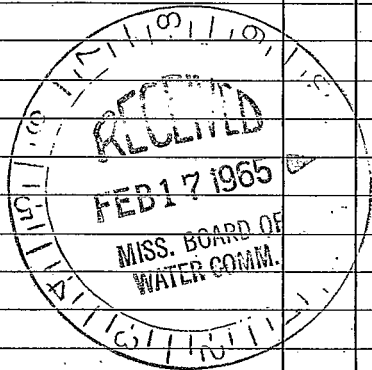

Well No.

(Use Back Side)

1. The first part of the document discusses the importance of maintaining accurate records of all transactions. It emphasizes that this is crucial for the company's financial health and for providing reliable information to stakeholders.

2. The second part of the document outlines the specific procedures for recording transactions. It details the steps from initial entry to final review, ensuring that all necessary information is captured and verified.

3. The third part of the document addresses the role of the accounting department in this process. It highlights the need for clear communication and collaboration between different departments to ensure the accuracy and completeness of the records.

4. The fourth part of the document discusses the importance of regular audits and reviews. It explains how these activities help to identify any discrepancies or errors and ensure that the records are up-to-date and accurate.

5. The fifth part of the document provides a summary of the key points discussed and offers some final thoughts on the importance of maintaining accurate records. It concludes by stating that this is a fundamental aspect of good financial management.