

WINSTON

MISSISSIPPI BOARD OF WATER COMMISSIONERS

CODED

M10

6 136

6-9-66

WATER WELL DRILLERS LOG

Date: 6-9, 1966, Driller: Mercury Drilling Co, County WINSTON

(Name)

(1) Owner of Land: LAMAR White (Name)

RT. A - MACON, MISS (Address) 22 14 14

(2) Location: 1/4, 1/4, Sec. - T. R. 16 miles S.E. of LOUISIANA (distance) (direction) (Nearest Town)

(3) Topography: Hilly (Hilly) (Flat) (Level)

(4) Purpose of Well: DOMESTIC (Domestic Irrigation Municipal, Industrial, Other)

Description & Color of Materials Sand, Clay, Red Clay, Shell, etc.	Thick- ness Feet	Depth Feet
TOP SOIL	0	1
Red CLAY + SAND	1	8
Yellow SAND	8	10
THIN ROCK		
Red SAND	10	12
THIN ROCK		
Red SAND + ROCK	15	15
Red SAND	15	18
2" ROCK		
White SAND	18	150

Information upon completion of well:

(1) Diameter 2 inches.

(2) Total Depth 150 feet.

(3) Water Level 126 feet below top of ground.

(4) Cased to 140, Size 2

(5) Screen: Size 1 1/4, Length 6'


(6) Were any formations sealed against pollution?

yes, no. [check]

If YES depth of formation

Why

Drillers Remarks:

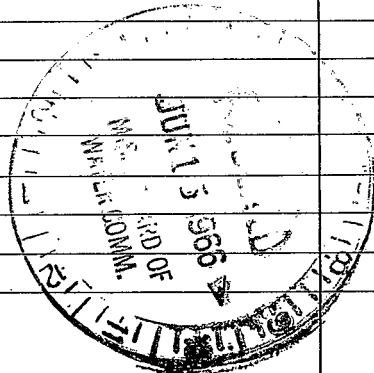

(Use Back Side)

Well No.

