

5 13T

330250N0885330

Winston
M 11
3-68

540 MISSISSIPPI
BOARD OF WATER COMMISSIONERS
416 North State Street
Jackson, Mississippi 39201

CODED TELW

WATER WELL DRILLERS LOG

March 1968 Robert E. Raloff Co. Winston
date well completed firm name county well located

LANDOWNER: Ellison Ridge
Water Assn.
Louisville, Miss.
(mailing address)


description of formations encountered	from to	
Clay	0	15
Sand, Rock	15	16
Red Sand	16	96
Sandy shale	96	114
Sand (76')	114	190
Shale	190	194

WELL LOCATION:
sec 20 T 14 N R 14 E
14 miles East of Louisville
(distance) (direction) (nearest town)

WELL PURPOSE: Community Well
(home, irrigation, municipal, industrial)

- WELL COMPLETION DATA:
- (1) diameter (inches) 10x6
 - (2) total depth (feet) 188
 - (3) static water level (feet) 98 ^{below}/_{above} top of ground.
 - (4) casing Bl. St., 168, (material) (depth)
10" if telescope see back. (size)
 - (5) screen 20', 168 (length) (depth to top)
6" St. St. (size) (material)
 - (6) pump 15 200 (HP) (yield gpm)
electric (type power)
 - (7) electric log No (yes or no)
 - (8) how well bottom plugged BPU

DRILLERS REMARKS:

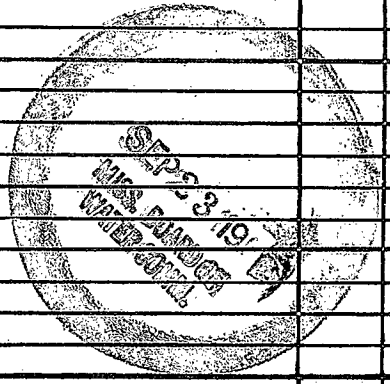

④

If well telescopes please sketch and show depths.

GROUND LEVEL

SECTION _____

Please indicate well location X.

ADDITIONAL INFORMATION

If more than one screen, show locations of each on sketch.