

WINSTON
AM 12

WATER WELL DRILLERS LOG

CODED *H*

6 135

Date: *5-7-64* 19 *64*, Driller: *MERRITT DRILLING* County *WINSTON*

(Name)

(1) Owner of Land: *Norman White*
(Name)
Rt 4 - Louisville, Miss
(Address)
20 14-14
(2) Location: $\frac{1}{4}$, $\frac{1}{4}$, Sec. *T R*
9 miles *S.E.*, of *LOUISVILLE*
(distance) (direction) (Nearest Town)
(3) Topography: *HILLX*
(Hilly) (Flat) (Level)
(4) Purpose of Well: *DOMESTIC*
(Domestic Irrigation
Municipal, Industrial, Other)


Description & Color of Materials Sand, Clay, Red Clay, Shell, etc.	Thick- ness Feet	Depth Feet
<i>Red clay</i>	<i>0</i>	<i>18</i>
<i>TAN SAND</i>	<i>18</i>	<i>90</i>
<i>Coarse TAN & Whitesand</i>	<i>90</i>	<i>135</i>
<i>PINK CLAY & SAND</i>	<i>135</i>	<i>147</i>

Information upon completion of well:

(1) Diameter *2* inches.
(2) Total Depth *147* feet.
(3) Water Level *105* feet below top of ground.
(4) Cased to *126*, Size *2*
(5) Screen: Size *1 1/4*, Length *6'*
(6) Were any formations sealed against pollution?
____ yes, ____ no.

If YES depth of formation _____
Why _____

Drillers Remarks: _____

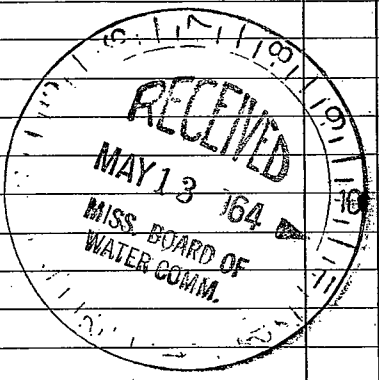

(Use Back Side)

Well No.

