

WINSTON  
M14  
9-30-77  
E log # 34

MISSISSIPPI  
BOARD OF WATER COMMISSIONERS  
416 North State Street  
Jackson, Mississippi 39201

520' MSL  
CODED

WATER WELL DRILLERS LOG

Sept. 30 1977 Robert E. Rothill Co. Inc. Winston  
date well completed firm name county well located

LANDOWNER:  
Eblison Ridge W. A.  
Louisville, Ms.  
(mailing address)

description of formations encountered	depth	
	from	to
Top Soil - Clay	0	21
Red Clay	21	42
Sand	42	63
Sand	63	84
Sandy Clay	84	105
Clay - Sand	105	126
Sand	126	147
Sand	147	168
Sandy Clay	168	189
Clay	189	197

WELL LOCATION:  
sec. 20 T. 14 N R. 14 E  
14 miles EAST of Louisville  
(distance) (direction) (nearest town)

WELL PURPOSE: Community Well  
(home, irrigation, municipal, industrial)

- WELL COMPLETION DATA:
- (1) diameter (inches) 10" x 6"
  - (2) total depth (feet) 188'
  - (3) static water level (feet) 98' below top of ground.
  - (4) casing black steel 168'  
(material) (depth)
  - 10" If telescopic see back:  
(size)
  - (5) screen 20' 168'  
(length) (depth to top)
  - 6" S.S.S.  
(size) (material)
  - (6) pump 15 HP 200 (yield gpm)  
electric (type power)
  - (7) electric log No Yes  
(yes or no)  
U.S.G.S.  
(organization running log)
  - (8) how well bottom plugged B.P.V.

CODED

RECEIVED

OCT 19 1978


MISS. BD. OF WATER COMM

DRILLERS REMARKS:

(X)

If well telescopes please sketch and show depths.

GROUND LEVEL

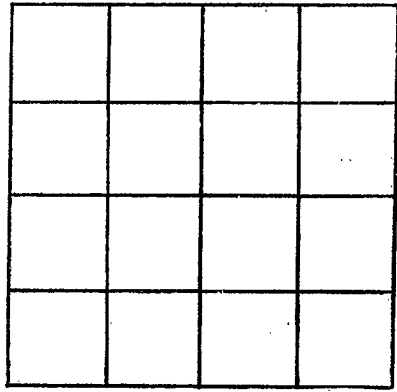

SECTION \_\_\_\_\_

Please indicate well location X.

ADDITIONAL INFORMATION

A series of horizontal lines for recording additional information.

If more than one screen, show locations of each on sketch.