| County: Wins Tow | |
|---------------------------------|--|
| Permit #: | |
| Driller: Parks & Parks | |
| Date drilling completed: 819/11 | |

State Well Report

Part 1 - Driller's Log

Mississippi Department of Environmental Quality Office of Land and Water Resources P.O. Box 10631 Jackson, MS 39289-0631 (601)961-5210 (601)354-6938 (fax)

| For Office Use Only: | | | |
|----------------------|--|--|--|
| Aquifer: | | | |
| Well #: | | | |
| L. S. Elevation: | | | |
| E-log #: | | | |


State Law requires that this report be prepared by the license holder responsible for the work and filed with the Department at the above address within 30 days of completion of drilling of the well or borehole.

| Department at the above address within 30 days of comp | tetion of artiting of the well or borehole. |
|---|---|
| Information on Well Owner | Well or Borehole Location |
| (Landowner if borehole is not for a water well) Owner Name STANKY FAVES | Latitude: 33 ° 02 '59 " Longitude: 88 ° 53 ' 35 " |
| | Method of Lat/Long (circle one): Conventional Survey, |
| Mailing Address: 6275 CRYSTAL Ridge Ad. | USGS quad, Hand-held GPS, Survey-grade GPS |
| | 5W 1/4 NW 1/4 Sec 20 Twn 14N Rng 14E OF |
| Louisville, MS 32339 City State Zip Code | |
| | Distance Direction Nearest Town 12 Miles SE of Lowsville |
| Telephone No. (662) 803-7567 | |
| Well / Borel | |
| Date drilling started: 8/17/11 Date drilling completed: 8/19/ | Hole depth: 180 Hole diameter: 8" |
| I continue of the course of any surface water used for drilling. | |
| Method of dosing and volume of Chlorine used in drilling and develo | opment: |
| Logs run (circle all applicable): No log run Electric Gamma Ray Name of organization running log(s): | Density Sonic Neutron Other: |
| Purpose of borehole (check one): Water Well Geotechnical/Geolo | gical Investigation Ground Source Heat Pump |
| Seismic Survey Other (describe) | |
| If drilling is not related to water well construction | s, skip the remainder of this block |
| Purpose of Well (check one): Home Industrial Public Supply_ | IrrigationFish CultureOther: |
| If a flowing well, method of flow regulation: ValveOtt | her (describe) |
| Static Water Level:feet above or below (circle one) la | nd surface Date measured: 8/19/11 |
| Method of Measurement (circle one) steel tape electric tape | air line other: |
| Well depth: 180 Well grouted to a depth of 50 feet Type of | A |
| Casing length: 140 feet Casing diameter: 5 | inches Type of casing: |
| Screen length: 40 feet Screen diameter: 5 | inches Type of screen: PVC |
| Screen slot size:inches | 40 feet to /80 feet |
| Type of completion (circle all applicable) Gravel packed Underre | eamed Telescoped Open hole Natural Development |
| Other (describe): | |
| op of lap pipe or reduction in casing:feet. If teles | scoped or more than one screen, describe on next page |

Form: OLWR-SWR-1A

| If well telescopes, show depths on sketch. | | | - 41 41 |
|--|---------------------------------------|--------------|------------|
| Ground Level | Description of Formations Encountered | | To (depth) |
| | | Ground Level | |
| | Red Clay | 6 | 20 |
| | C/Ay + SAND | 30 | 56 |
| demont. | 50 SAND | 56 | 75 |
| B CSN Civi | SAND, Lignite + C/N | 1 75 | 96 |
| 8 2 | CIAY, ROCK + SAN | 0 96 | 116 |
| Hole plue | SAND | 116 | 180 |
| Sill the true to the true | | | |
| Si S'CASIN | | | |
| S"CASIN | 10 | | |
|); CASIN | 4 | | |
|) | | | |
| (3) (1) | | | |
| 12 27 | . 4. 3 | | |
| 140'-BOTA | ancising | | |
| 18: | 1 | | |
| | | - | |
| 40'-5".011 GANVEL ! | a Scarw | | |
| CAN'EL | nack | | |
| | roc | | |
| TD 180' | | | |
| | | | |
| | | | |
| • | | | Ţ. |
| | | | |

If more than one screen, show location of each on sketch

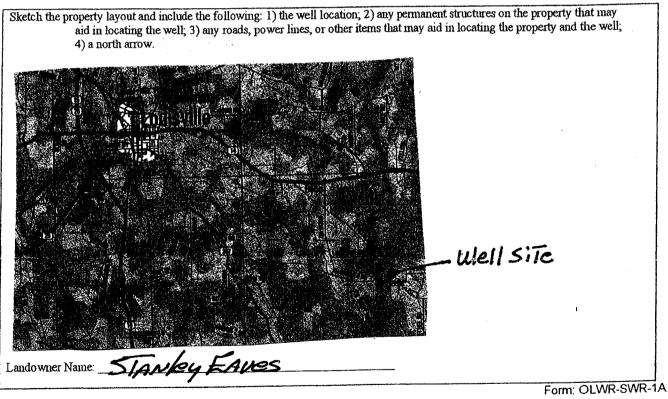

I certify that the well/borehole was drilled, constructed, and completed in accordance with all applicable requirements of the Mississippi Department of Environmental Quality and the Mississippi Department of Health regulations, if applicable, and state

laws Print Name of Responsible Licensee and License No.

Signature of Licensee

STATE WELL REPORT

County: Winston Permit #: Date completed:

Copy information from block on Part 1

Part 2

Pump Installer's Completion Report
Mississippi Department of Environmental Quality
Office of Land and Water Resources P.O. Box 10631 Jackson, MS 39289-0631 (601)961-5210 (601)354-6938 (fax)

| For Office Use Only: | | |
|----------------------|-----|--|
| Aquifer: | 216 | |
| Well #: | b | |
| Elevation: | | |

| This part of the report must be completed by a licensed water well contractor or a licensed pump installer. A copy of Part 1 of the report must be attached and both parts filed with the Department at the above address within 30 days of well completion. | | | |
|--|--|--|--|
| Well Owner Information | Well Location | | |
| Owner Name: STANLEY FAVES | Latitude: 33-02-59 Longitude: 88-53-35 | | |
| Mailing Address: B275 CR45A RIGHT | Method of Lat/Long (check one): Conventional Survey, | | |
| | USGS quad, Hand-held GPS, Survey-grade GPS | | |
| Louisville MS 39339 City State Zip Code | 5W 14 NW 14 Sec 20 T 14W R 14E | | |
| City State Zip Code | Distance Direction Nearest Town | | |
| Telephone No. (662)-803-7.567 | 12 Miles SE of Louisville | | |
| Pump Type Circle one | Power Type Circle one | | |
| Air Lift Jet Submersible | Diesel Engine Gasoline Engine Natural Gas | | |
| Bucket Piston Turbine | Electric Motor Hand Tractor PTO | | |
| Centrifugal Rotary Flowing Well | Windmill Other (specify): | | |
| Other (specify): | Horse Power Rating of Motor: | | |
| Date Pump Installed: 8/19/11 | Setting Depth: 147 feet | | |
| Rated Pump Capacity:Gallons Per Minute | Number of Stages: | | |
| Pump Test Data | Method of Measuring Water Level Circle one | | |
| Date Well Tested: | Air Line Electric Measuring Line Steel Tape | | |
| Static Water Level (A): | Other (specify): | | |
| Pumping Water Level (B): 76 Feet Below Land Surface | outer (openity): | | |
| Drawdown [(B) – (A)]:Feet Below Land Surface | For flowing well, measured shut in head:feet | | |
| Test Pumping Rate: 30 Gallons Per Minute | Well yieldedGPM with a drawdown of | | |
| Duration of Pump Test (minimum 4 hours):hours | feet afterhours of pumping | | |
| HEREBY CERTIFY that the above statements are true to the best of | my knowledge | | |
| Print Name of Pump Installer and License No. (if applicable) | Signature of tump Installer Form: OLWR-SWR-1B | | |
| | ALG 2 6 2011 | | |