

Winston
 M 2000
 6-22-76

MISSISSIPPI
 BOARD OF WATER COMMISSIONERS
 416 North State Street
 13T Jackson, Mississippi 39201

WATER WELL DRILLERS LOG

6-22-76 JHM Dausle Winston
 date well completed firm name county well located

LANDOWNER: Max Fulcher
 Louisville Miss
 (mailing address)
 WELL LOCATION:
 sec. 17 T 14 N R14 E
 S W
 11 miles S.E. of Louisville
 (distance) (direction) (nearest town)

description of formations encountered	from	to
red clay	0	15
red sand	15	30
white sand	30	40

WELL PURPOSE: Home
 (home, irrigation, municipal, industrial)

WELL COMPLETION DATA:
 (1) diameter (inches) 2"
 (2) total depth (feet) 85
 (3) static water level (feet) 60 below top of ground.
 (4) casing PVC 80 (material) (depth)
 2" (size) if telescope see back.
 (5) screen 5' 85 80 (length) (depth to top)
 1 1/2 inch 10 mesh SS (size) (material)
 (6) pump 1 (HP) 8 (yield gpm)
 electric (type power)
 (7) electric log No. (yes or no)
 (organization running log)
 (8) how well bottom plugged


DRILLERS REMARKS:

RECEIVED
 SEP 15 1976

MISS. Bd. OF WATER COMM.

If well telescopes please sketch and show depths.

GROUND LEVEL

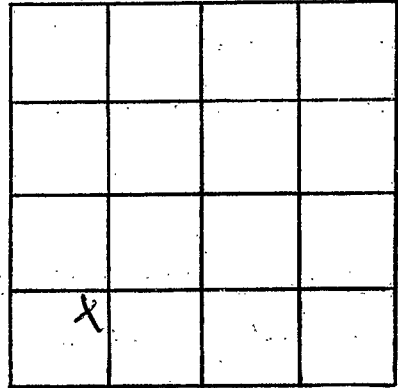

SECTION 17

Please indicate well location X.

ADDITIONAL INFORMATION

If more than one screen, show locations of each on sketch.