

MISSISSIPPI  
BOARD OF WATER COMMISSIONERS  
416 North State Street  
Jackson, Mississippi 39201

cooled

WATER WELL DRILLERS LOG


Winston  
N 4  
6-22-70

6-22 1970 Thomas & Son Winston  
date well completed firm name county well located

LANDOWNER: <u>Mr. Adeock</u> <u>Noxipater, Missi</u>  (mailing address)	description of formations encountered	from	to
	<u>Dirt</u>	<u>0</u>	<u>10</u>
	<u>Chalk</u>	<u>10</u>	<u>25</u>
	<u>SAND</u>	<u>25</u>	<u>48</u>
<b>WELL LOCATION:</b>			
sec. <u>31</u> T. <u>13</u> N. R. <u>10</u> E			
<u>7 1/2</u> miles <u>W</u> of <u>Plattsboro</u>			
(distance) (direction) (nearest town)			
<b>WELL PURPOSE:</b> <u>Chicken House</u> (home, irrigation, municipal, industrial)			
<b>WELL COMPLETION DATA:</b>			
(1) diameter (inches) <u>2</u>			
(2) total depth (feet) <u>48</u>			
(3) static water level (feet) <u>20</u> <u>below</u> above top of ground.			
(4) casing <u>Galv.</u> <u>42</u> (material) (depth)			
<u>2</u> if telescope see back. (size)			
(5) screen <u>6</u> <u>42</u> (length) (depth to top)			
<u>1 1/4</u> <u>515</u> (size) (material)			
(6) pump <u>1</u> <u>10</u> (HP) (yield gpm)			
<u>Elec</u> (type power)			
(7) electric log <u>NO</u> (yes or no)			
(organization running log)			
(8) how well bottom plugged			
<b>DRILLERS REMARKS:</b>		<b>JUL 28 1970</b>	
		MISS. BD. OF WATER COMM.	

If well telescopes please sketch and show depths.

GROUND LEVEL

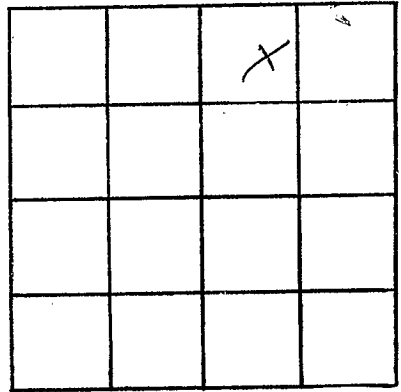

SECTION 31

Please indicate well location X.

ADDITIONAL INFORMATION

If more than one screen, show locations of each on sketch.