

WINSTON
No
3-29-71

MISSISSIPPI
BOARD OF WATER COMMISSIONERS
416 North State Street
Jackson, Mississippi 39201

CODED

WATER WELL DRILLERS LOG

3-29 1971 Thomas Son Winston
date well completed firm name county well located

LANDOWNER: Bruce Myle

Noxapater, Miss

(mailing address)

WELL LOCATION:

sec. 13 T. 13 N. R. 10 E.

9 miles W of Noxapater
(distance) (direction) (nearest town)

WELL PURPOSE:

(Home) Irrigation, municipal, industrial

WELL COMPLETION DATA:

- (1) diameter (inches) 2
- (2) total depth (feet) 316
- (3) static water level (feet) 110 ^(below) above top of ground.
- (4) casing Galv. 300
(material) (depth)
2 if telescope see back.
(size)
- (5) screen 6 310
(length) (depth to top)
2" 1/2 slot S.S.
(size) (material)
- (6) pump 2 Air 12
(HP) (yield gpm)
Elec
(type power)
- (7) electric log NO
(yes or no)

(organization running log)

(8) how well bottom plugged Point

Description of formations encountered	from	to
	<u>Red Clay</u>	<u>0</u>
<u>Soft Chalk</u>	<u>15</u>	<u>22</u>
<u>Black Dirt</u>	<u>22</u>	<u>28</u>
<u>Blue Chalk</u>	<u>28</u>	<u>58</u>
<u>Brown Dirt</u>	<u>58</u>	<u>73</u>
<u>Black Dirt</u>	<u>73</u>	<u>80</u>
<u>Rock & Black Dirt</u>	<u>80</u>	<u>106</u>
<u>Fine silt</u>	<u>106</u>	<u>133</u>
<u>Black Dirt</u>	<u>133</u>	<u>211</u>
<u>Fine Greyish Sand</u>	<u>211</u>	<u>221</u>
<u>Hard Dirt</u>	<u>221</u>	<u>230</u>
<u>Fine Greyish Sand</u>	<u>230</u>	<u>255</u>
<u>Blue Chalk</u>	<u>255</u>	<u>300</u>
<u>Coarse Sand</u>	<u>300</u>	<u>315</u>

CODED


JUN 10 1971

DRILLERS REMARKS:

MISS. BD. OF
WATER COMM.

If well telescopes please sketch and show depths.

GROUND LEVEL

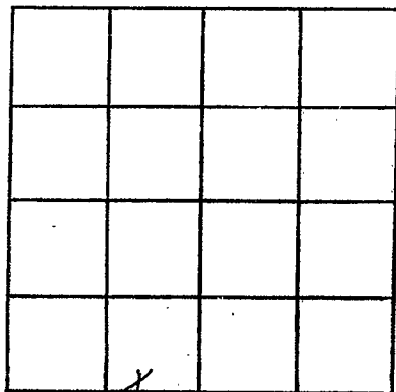

SECTION 13

Please indicate well location X.

ADDITIONAL INFORMATION

If more than one screen, show locations of each on sketch.