

WINSTON
N 9
10-1-73

MISSISSIPPI
 BOARD OF WATER COMMISSIONERS
 416 North State Street
 Jackson, Mississippi 39201

CODED

WATER WELL DRILLERS LOG

10-1-73 *H. H. McDaniel* *Winston*
 date well completed firm name county well located

LANDOWNER: <i>W. H. Bell Co. Co. Co. Co. Co.</i>	description of formations encountered	from	to
<i>Louisville Miss</i>	<i>white clay</i>	<i>0</i>	<i>15</i>
(mailing address)	<i>white rock</i>	<i>15</i>	<i>20</i>
WELL LOCATION: sec. <i>17</i> T. <i>13</i> N. R. <i>10</i> E	<i>sand</i>	<i>20</i>	<i>45</i>
<i>20</i> miles S.W. of <i>Louisville</i>	<i>gray clay</i>	<i>45</i>	<i>55</i>
(distance) (direction) (nearest town)	<i>gray sand</i>	<i>55</i>	<i>162</i>
WELL PURPOSE: <i>Home</i> (home, irrigation, municipal, industrial)			
WELL COMPLETION DATA:			
(1) diameter (inches) <i>2"</i>			
(2) total depth (feet) <i>162'</i>			
(3) static water level (feet) <i>110</i> below above top of ground.			
(4) casing <i>steel</i> <i>126'</i> (material) (depth)			
<i>2"</i> If telescope see back. (size)			
(5) screen <i>5-80</i> <i>162-157</i> (length) (depth to top)			
<i>1 1/4"</i> <i>SS</i> (size) (material)			
(6) pump <i>1</i> <i>3</i> (HP) (yield gpm)			
<i>electric</i> (type power)			
(7) electric log <i>no</i> (yes or no)			
(organization running log)			
(8) how well bottom plugged			
DRILLERS REMARKS:			


CODED

NOV 26 1973

MISS. DIV. OF
 WATER CONTROL

If well telescopes please sketch and show depths.

GROUND LEVEL

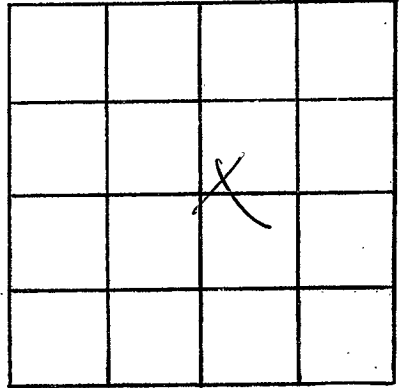

SECTION 17

Please indicate well location X.

ADDITIONAL INFORMATION

If more than one screen,
show locations of each on sketch.