

Winston
 N 11
 6-6-75

MISSISSIPPI
 BOARD OF WATER COMMISSIONERS
 416 North State Street
 Jackson, Mississippi 39201

CODED

WATER WELL DRILLERS LOG

6-6 1975 J.H.M. Javal *Javal* Winston
 date well completed firm name county well located

LANDOWNER: *V.E. Navell*
Louisville Miss
 (mailing address)

description of formations encountered	from	to
	<i>red clay</i>	<i>0</i>
<i>gray clay</i>	<i>23</i>	<i>115</i>
<i>fine sand clay</i>	<i>115</i>	<i>130</i>
<i>sand</i>	<i>130</i>	<i>150</i>

WELL LOCATION:
 sec *3* T *13* (N) R *18* (E) *137*
15 miles *SW* of *Louisville*
 (distance) (direction) (nearest town)

1 mi S of
 HINZE

WELL PURPOSE: *Home*
 (home, irrigation, municipal, industrial)

- WELL COMPLETION DATA:
- (1) diameter (inches) *2"*
 - (2) total depth (feet) *150*
 - (3) static water level (feet) *55* below top of ground.
 - (4) casing *steel* *127'*
 (material) (depth)
2" if telescope see back.
 (size)
 - (5) screen *5* *145 140*
 (length) (depth to top)
1/2 *galat 55*
 (size) (material)
 - (6) pump *1* *10*
 (HP) (yield gpm)
electric
 (type power)
 - (7) electric log *no*
 (yes or no)
 (organization running log)
 - (8) how well bottom plugged

REGISTERED
 JUN 25 1975

MISS. BD. OF WATER COMMISSIONERS

DRILLERS REMARKS:

If well telescopes please sketch and show depths.


GROUND LEVEL



126 ft
2" pipe



21 ft
1" pipe
5 ft sand
point

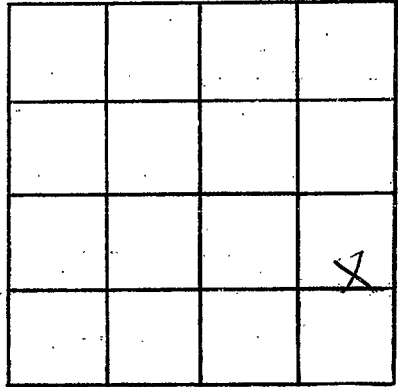

SECTION 3

Please indicate well location X.

ADDITIONAL INFORMATION

If more than one screen, show locations of each on sketch.